


ASSESSOR'S DATA:
 MAP No. 18
 BLOCK No. 01
 PARCEL No. 11

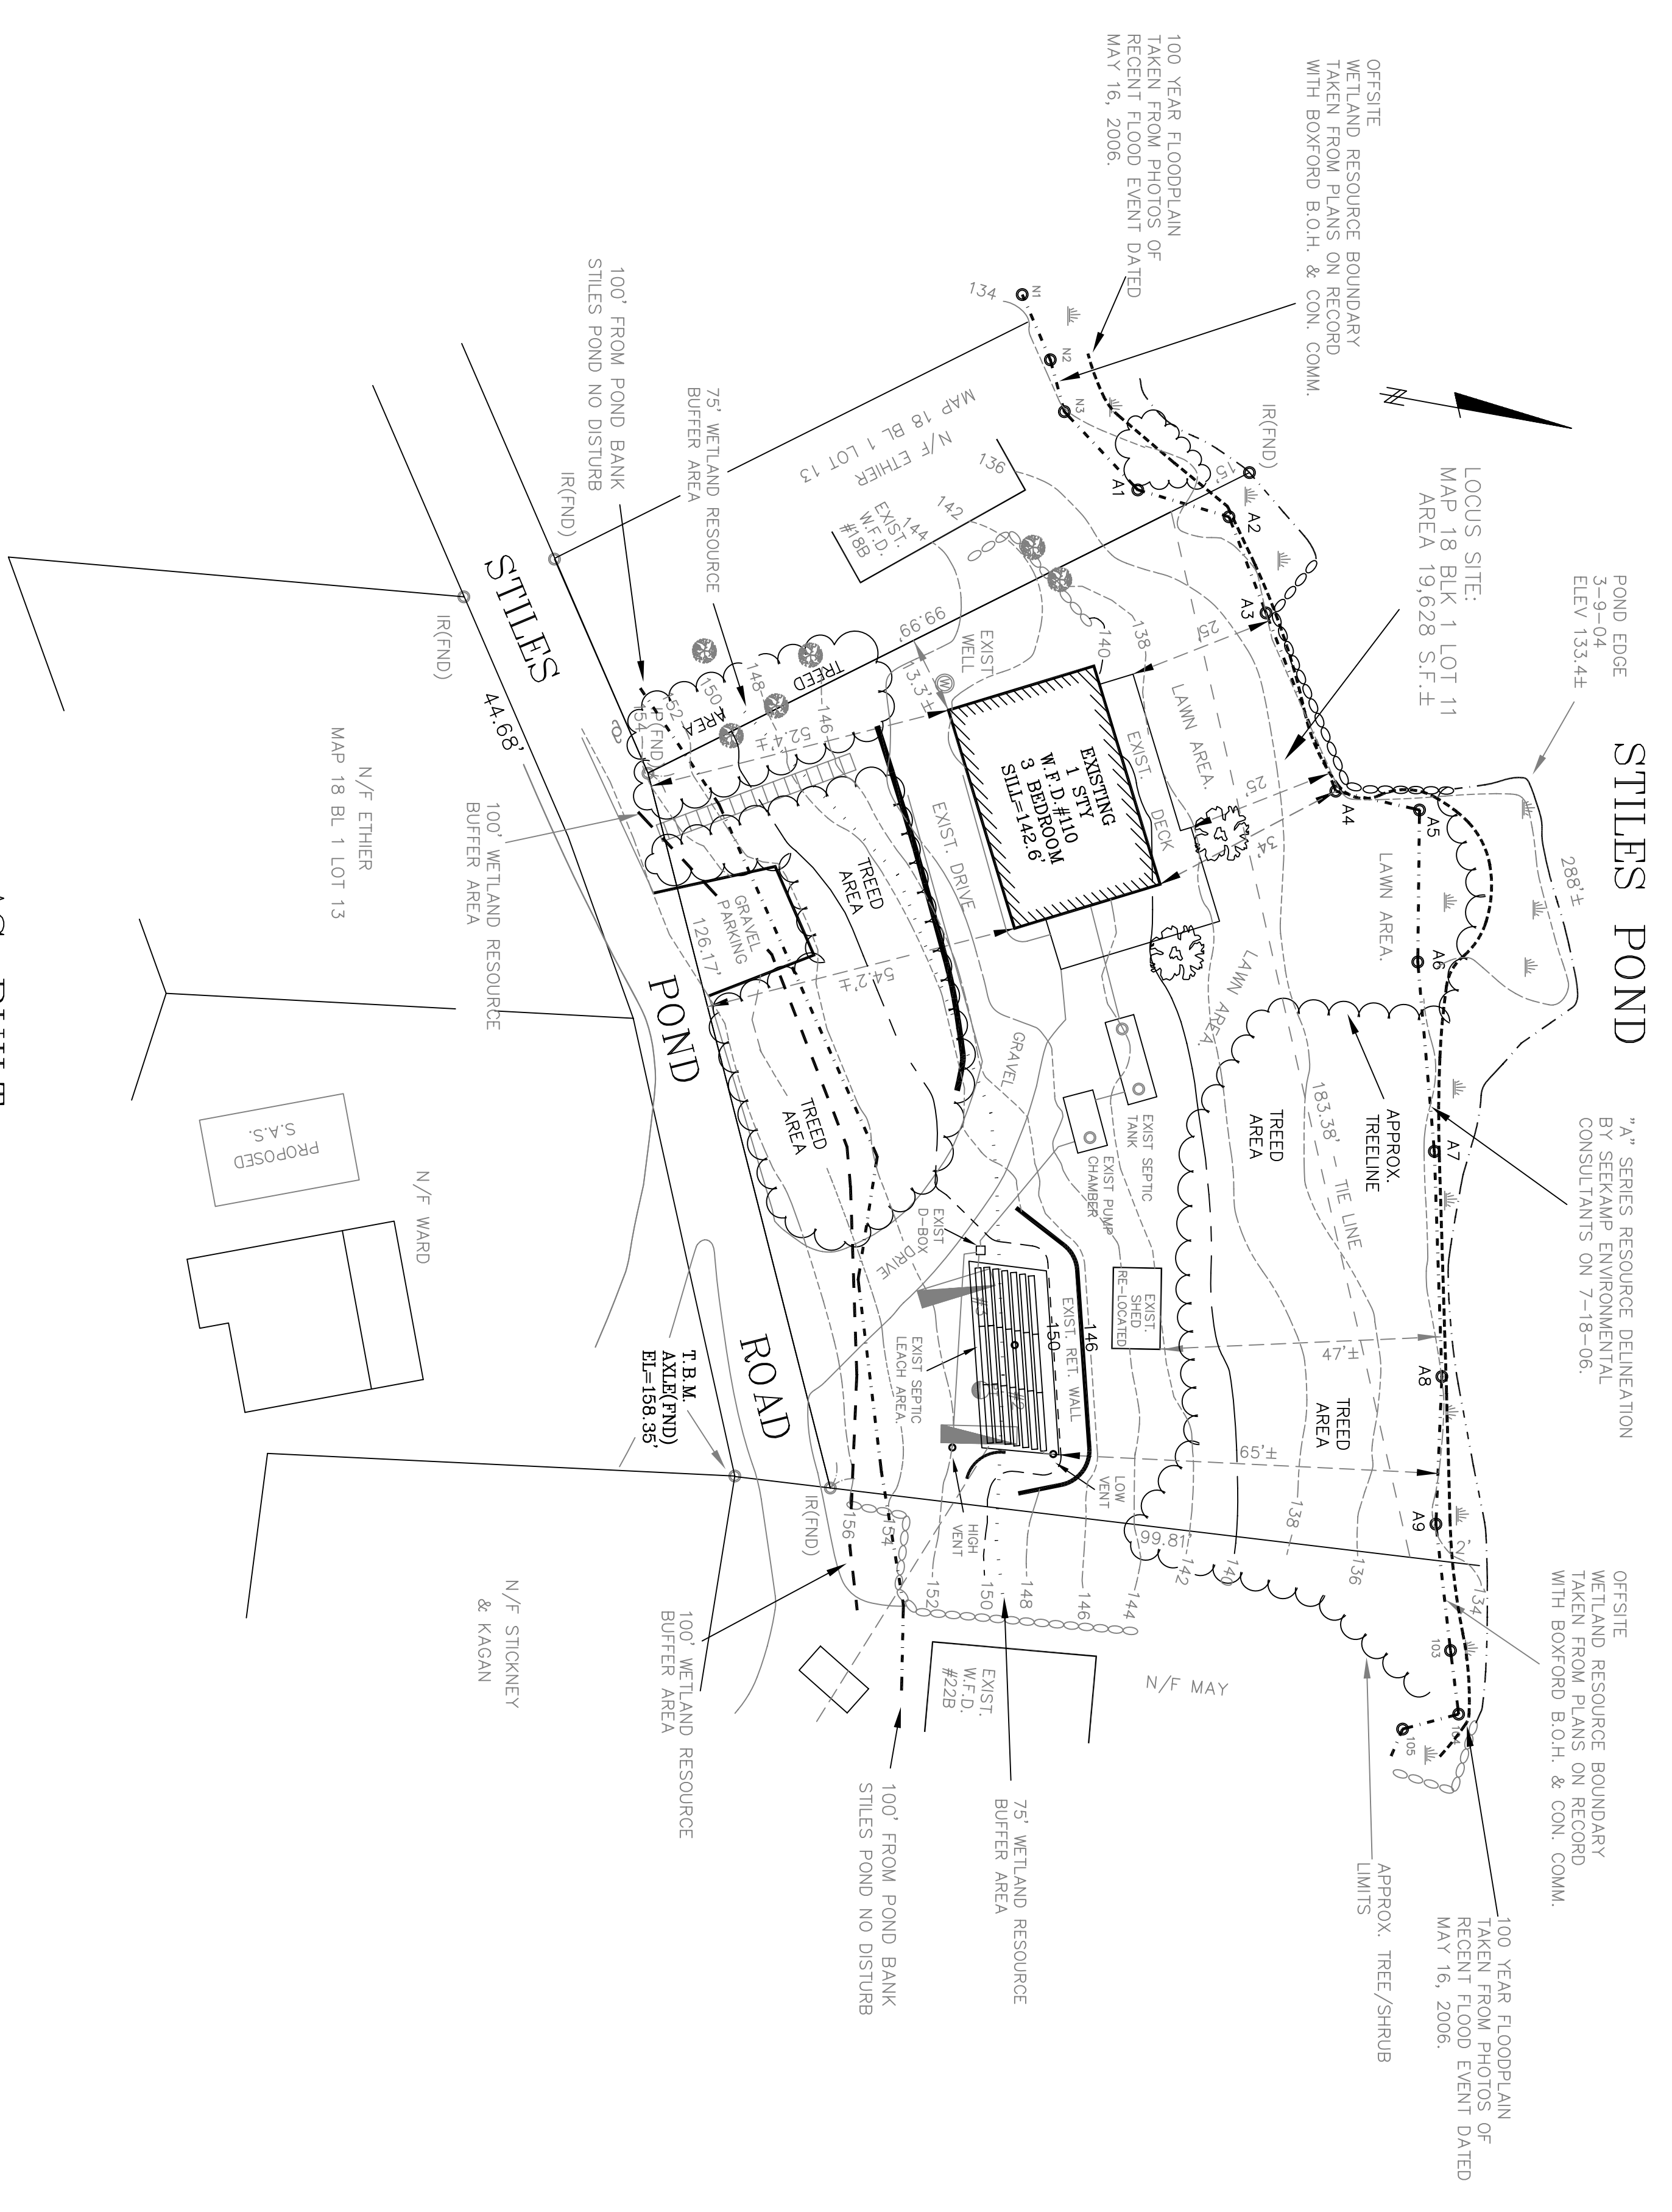

AS-BUILT
 CONSERVATION SITE PLAN

DEP FILE #114-996 AND #114-1015


SCALE 1" = 20'

NOTE:
 THIS AS-BUILT PLAN CERTIFIES THAT THE APPLICANT/OWNER HAS COMPLETED THE PROJECT WORK IN COMPLIANCE WITH THE APPROVED ORDER OF CONDITIONS, INCLUDING ANY AMENDMENTS.

1- THE EXISTING CONDITIONS SHOWN FROM FIELD SURVEY CONDUCTED JULY 2012.

2- NO PORTION OF THE PROPOSED DWELLING ARE LOCATED WITHIN THE 100 YEAR FLOODPLAIN, AS DETERMINED FROM INSPECTION OF THE F.E.M.A. FIRM COMMUNITY PANEL NUMBER 250078 0010C DATED 6-3-91.

LOCUS DEED: BK 15426 PG 569

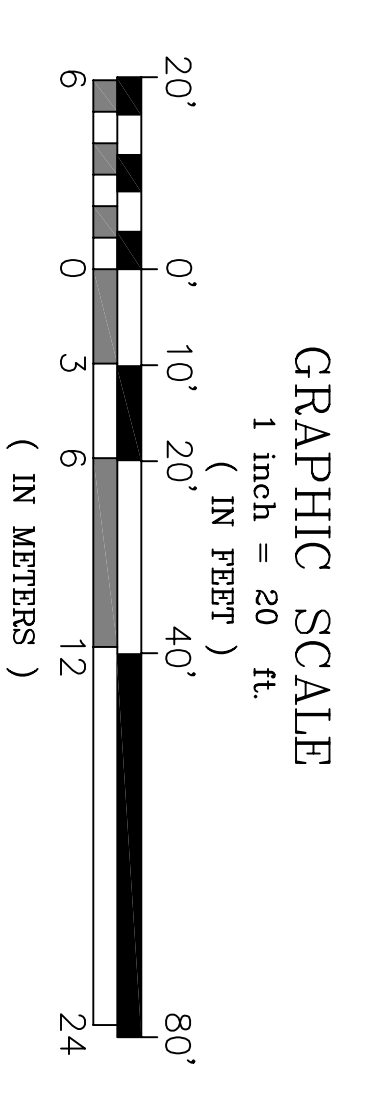

CERTIFICATIONS:
 I HEREBY CERTIFY THAT THIS PLAN CONFORMS TO THE RULES AND REGULATIONS OF THE REGISTRY OF DEEDS. I FURTHER CERTIFY THAT ALL SURVEYING CONFORMS TO THE TECHNICAL STANDARDS OF THE AMERICAN CONGRESS ON SURVEYING AND MAPPING. THE CERTIFICATION SHOWN HEREON IS INTENDED TO MEET REGISTRY OF DEED REQUIREMENTS AND IS NOT A CERTIFICATION AS TO THE TITLE OR OWNERSHIP OF THE PROPERTY SHOWN. OWNERS OF ADJOINING PARCELS ARE SHOWN ACCORDING TO CURRENT ASSESSOR'S MAPS.

WILLIAM G. HOLT, P.L.S. 36688 DATE

CONSERVATION AS-BUILT PLAN
 OF LAND LOCATED IN
 BOXFORD, MASSACHUSETTS

OWNER:
 BARBARA ALAKEL PARKE
 TAX MAP 18 BLK 1 LOT 11
 LOCUS DEED: BK 15426 PG 569

110 STILES POND ROAD
 BOXFORD, MASS.

PROFESSIONAL LAND SERVICES, L.C.
 1148 MAIN STREET
 HAVERHILL, MA 01830
 TEL: (978) 373-9950 FAX: (978) 373-4190
 FILE: WGH/ST/110SP-GR-AB.DWG



CALL TOLL FREE
 1-888-ONE-SAFE
 (1-888-344-7233)
 72 HOURS IN ADVANCE