


**NOTES:**

1. THIS PLAN HAS BEEN PREPARED TO ACCOMPANY A REQUEST FOR A CERTIFICATE OF COMPLIANCE TO THE BOXFORD CONSERVATION COMMISSION UNDER DEP FILE NUMBER #114-1173.
2. THIS FIELD SURVEY WAS COMPLETED IN NOVEMBER 2014 BY THE MORIN-CAMERON GROUP, INC.

**The Morin-Cameron GROUP, INC.**  
 CIVIL ENGINEERS | ENVIRONMENTAL CONSULTANTS  
 LAND SURVEYORS | LAND USE PLANNERS  
 447 BOSTON STREET, F. BOX 304, BOXFORD, MA 01750  
 TEL: 978-356-5408 FAX: 978-356-5409 WWW.MORIN-CAMERON.COM

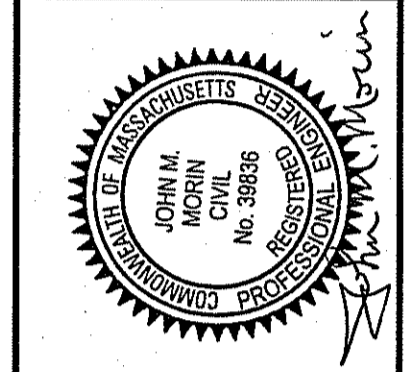

SURVEY BY: DY/RR  
 DRAFTED BY: WAS  
 CHECKED BY: JMM  
 APPROVED BY: JMM  
 SCALE: 1"=20'  
 DATE: JUNE 29, 2015

REVISIONS	
NO.	DESCRIPTION

**AS-BUILT PLAN OF LAND**  
**17 ADAMS ROAD**  
 (ASSESSOR'S MAP 11, BLOCK 1, LOT 24)  
**BOXFORD, MASSACHUSETTS**  
 PREPARED FOR:  
**JOHN ROGERS**

**CCAB**  
 DRAWING NO.  
**1 OF 1**

