


NOTES

- SEE TOWN OF BOXFORD ASSESSORS MAP #10 BLOCK #1 LOT #20, #34 AND #35, DEED BOOK #13703 PAGE #569, PLAN BOOK #252 PLAN #66, PLAN BOOK #310 PLAN #10 AND PLAN BOOK #355 PLAN #28 E.S.D.R.D. FOR SITE.
- BENCHMARK USED IS TBM-H 6" PINE, NAIL SET EL.=133.71


LEGEND

- ⊙ SMH SEWER MANHOLE
- CB ○ CB CATCH BASIN
- EHH ELECTRICAL HAND HOLE
- TBM-H TEMPORARY BENCHMARK
- 30" OAK TREE WITH SIZE AND TYPE
- X 116.13 SPOT ELEVATION
- 116--- ELEVATION CONTOUR
- S — SEWER PIPELINE
- D — DRAIN PIPELINE
- UE — UNDERGROUND ELECTRIC
- CEM. CONC. CEMENT CONCRETE
- BIT. CONC. BITUMINOUS CONCRETE
- PVC POLYVINYL CHLORIDE

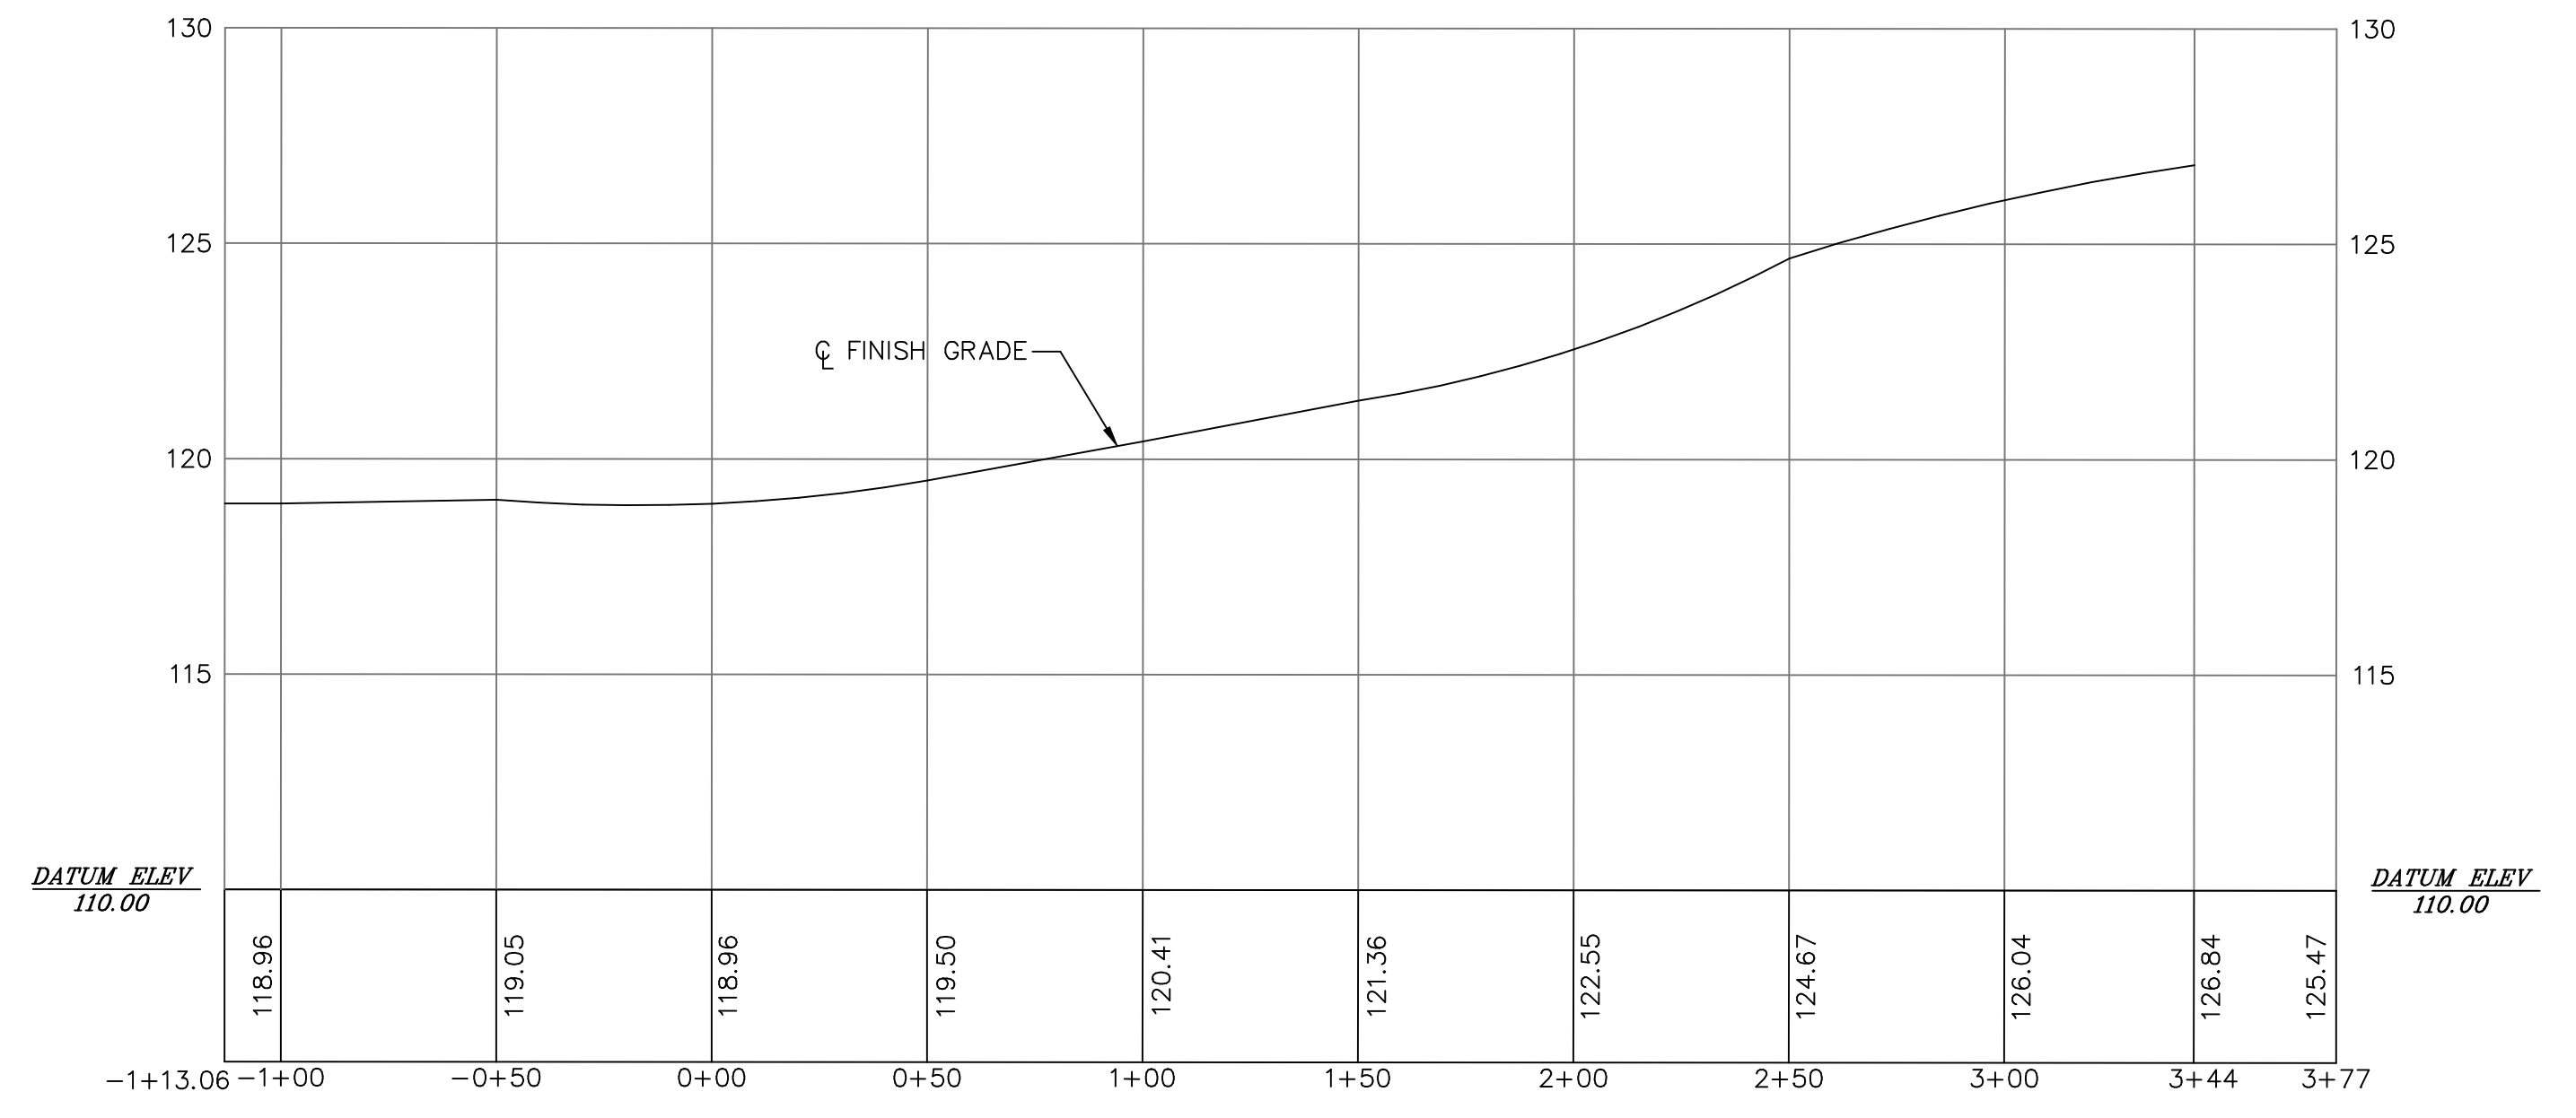

PROFILE
 1"=40' HOR.
 1"=4' VER.

**AS-BUILT PLAN & PROFILE
 BUDNICK WAY
 IN
 BOXFORD, MA
 PREPARED FOR
 BANK OF NEW ENGLAND
 31 PELHAM ROAD - P.O. BOX 29
 SALEM, NH**

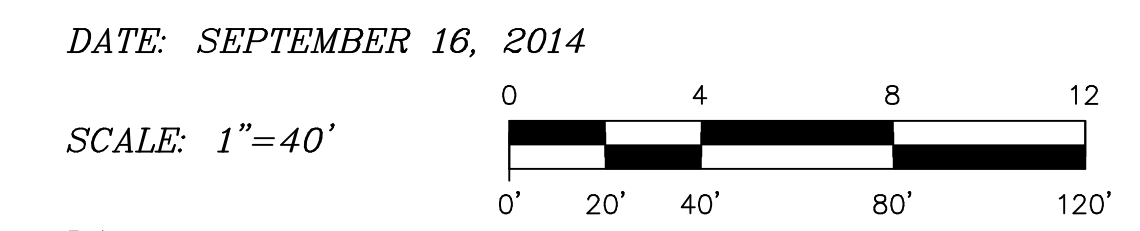

"I HEREBY CERTIFY THE FIELD SURVEY WORK COMPLIES WITH LAND COURT STANDARDS FOR ACCURACY

STEPHEN E. STAPINSKI, R.L.S. DATE: 9/16/14

MERRIMACK ENGINEERING SERVICES
 66 PARK STREET
 ANDOVER, MASSACHUSETTS 01810
 PHONE: (978) 475-3555 FAX: (978) 475-1448
 EMAIL: MERRENG@AOL.COM