

ISSUED TO TOWN FOR REVIEW	DATE:	02-10-10
ISSUED TO CLIENT FOR REVIEW	DATE:	02-05-10
STATUS:	BY:	MVE
REV:	BY:	A

THIS PLAN SHALL NOT BE MODIFIED WITHOUT WRITTEN PERMISSION FROM SEBAGO TECHNICS, INC. ANY ALTERATIONS, AUTHORIZED OR OTHERWISE, SHALL BE AT THE USER'S SOLE RISK AND WITHOUT LIABILITY TO SEBAGO TECHNICS, INC.


Sebago Technics
 Engineering Expertise You Can Build On.
 One Chapel Street, Suite B
 Westbrook, ME 04090-1393
 Tel: (207) 866-0277
 WWW.SEBAGOTECHNICS.COM

PROJECT NO.	FIELD BOOK	DESIGN	CHKD	DRAWN
00522	616A	MVE	BRF	BRF


AS-BUILT PROFILE: RED OAK DRIVE
 OF:
RED OAK RIDGE SUBDIVISION
 FALMOUTH, MAINE
 FOR RECORD OWNER:
RED OAK RIDGE HOMEOWNERS ASSOCIATION
 FALMOUTH, MAINE 04105

DATE: 02-04-10
 SCALE: AS SHOWN


SHEET 2 OF 2

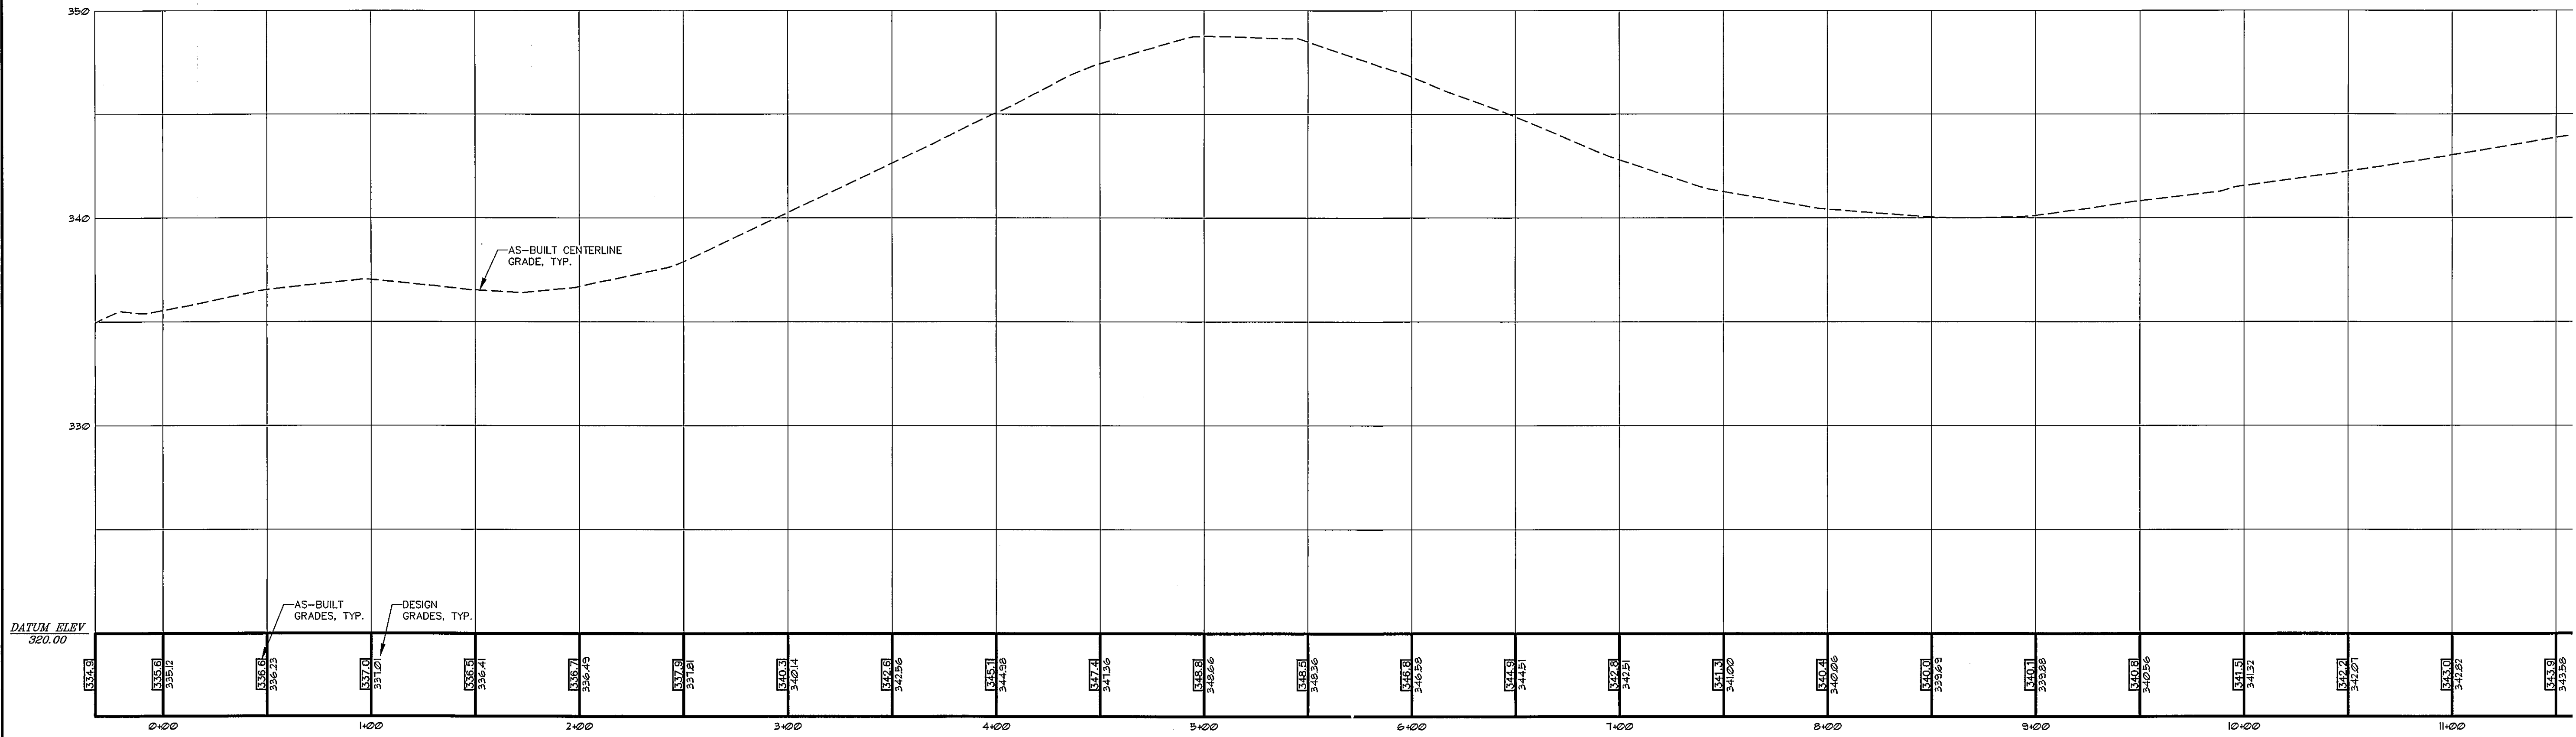

AS-BUILT PROFILE
 SCALE: VERT. 1"=4'
 HORIZ. 1"=40'

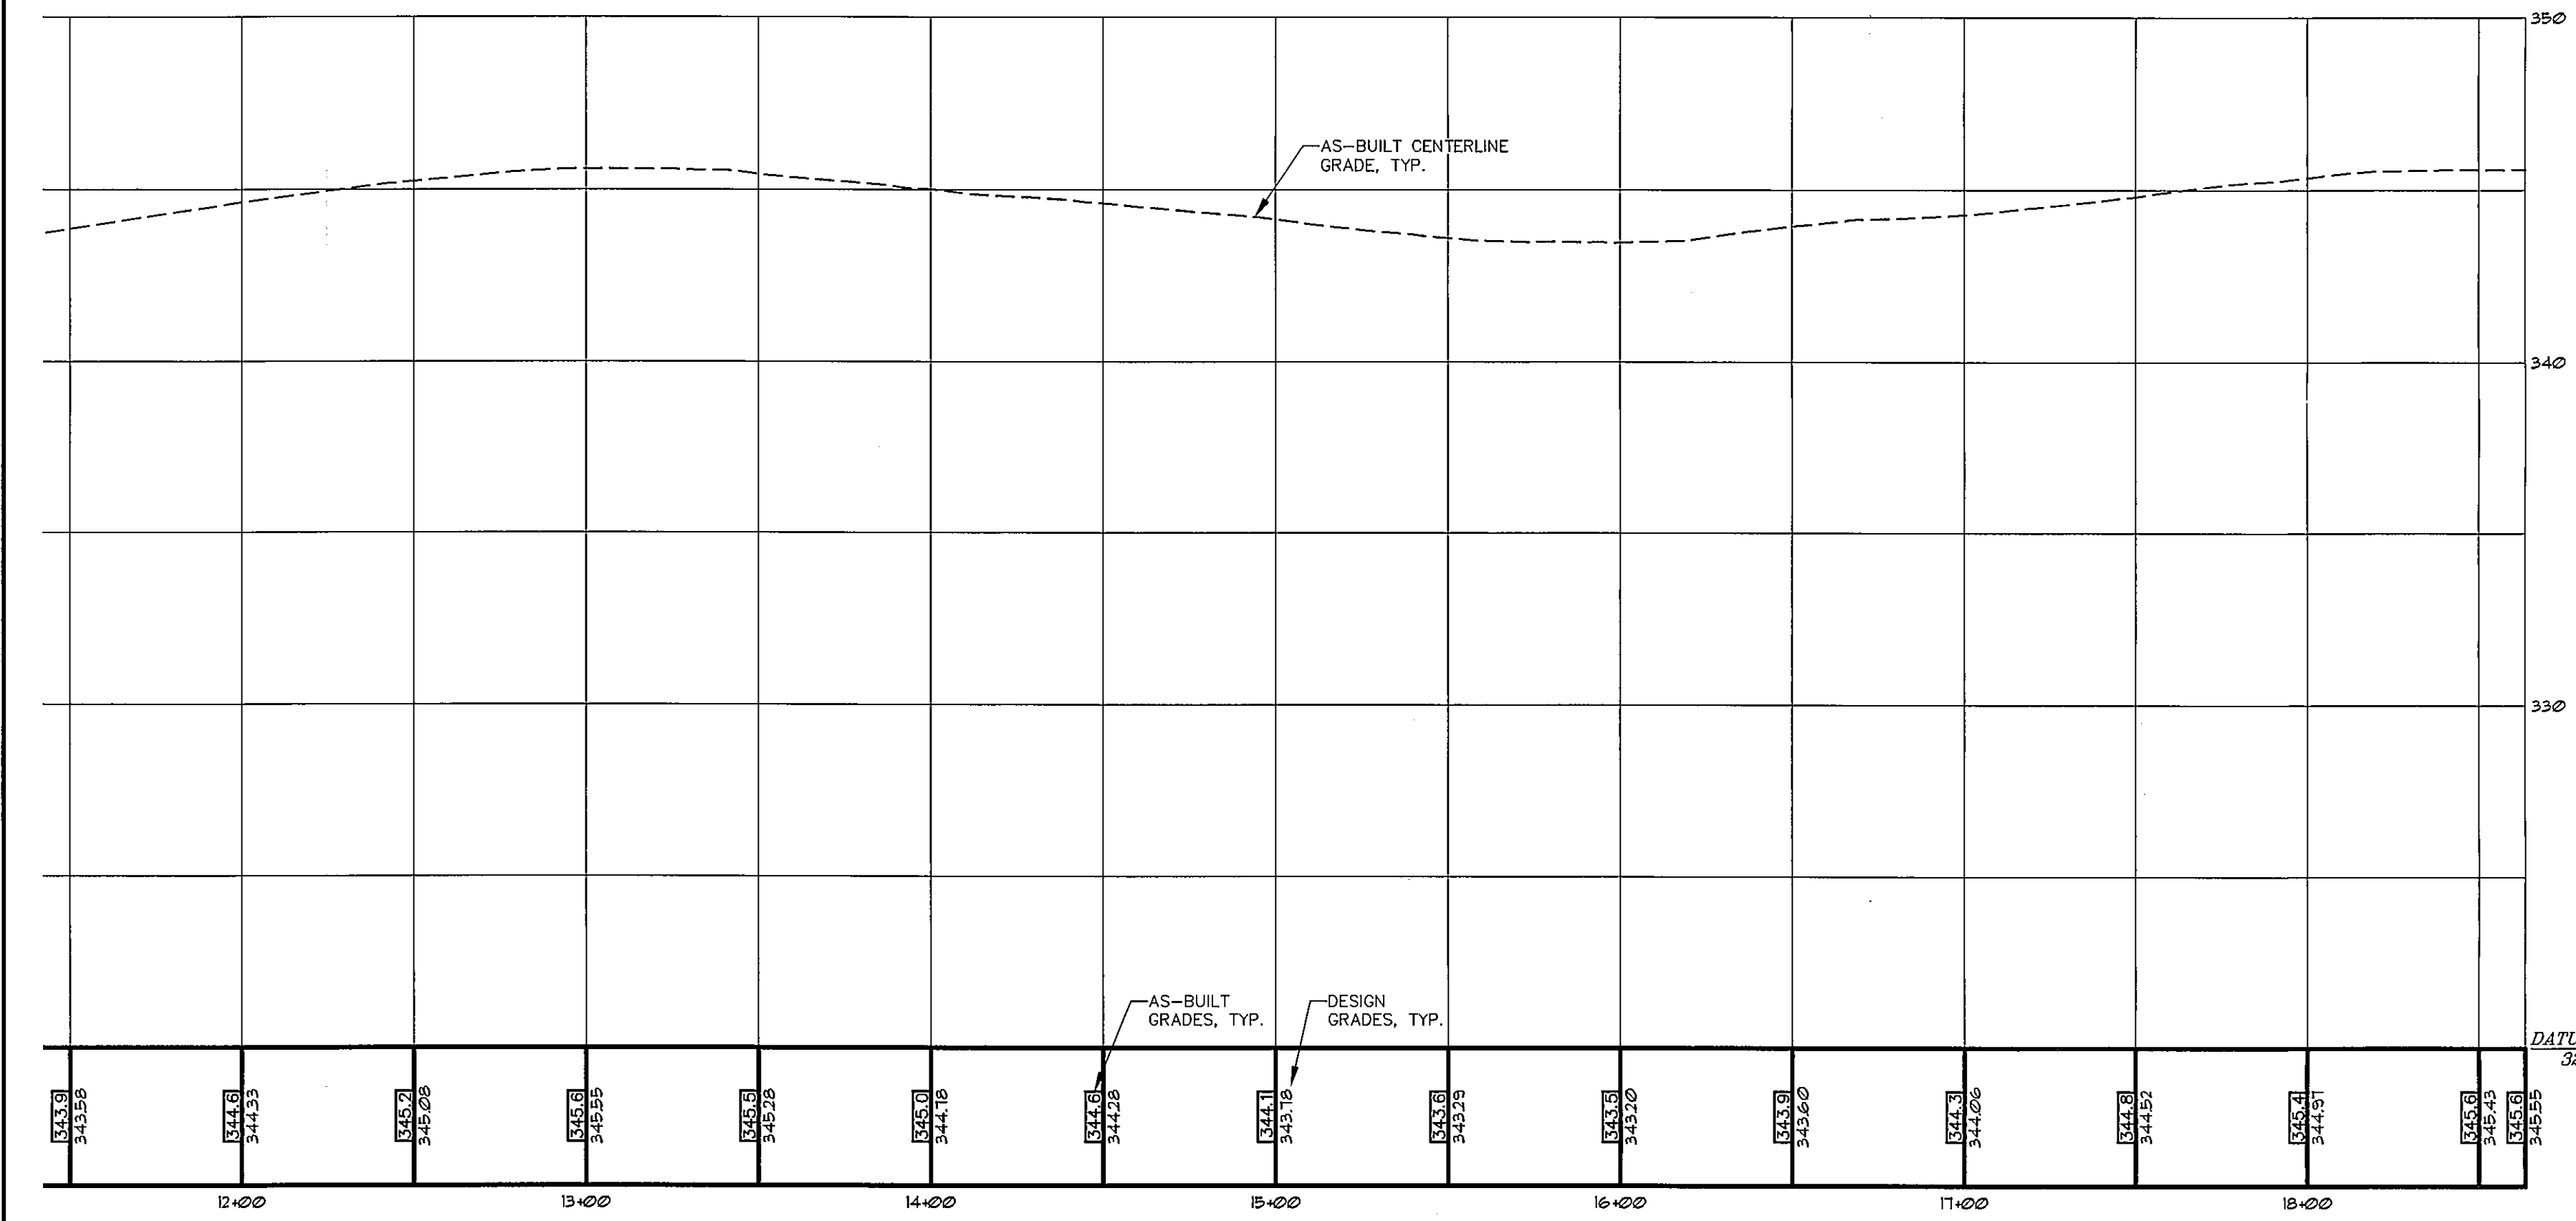

AS-BUILT PROFILE
 SCALE: VERT. 1"=4'
 HORIZ. 1"=40'

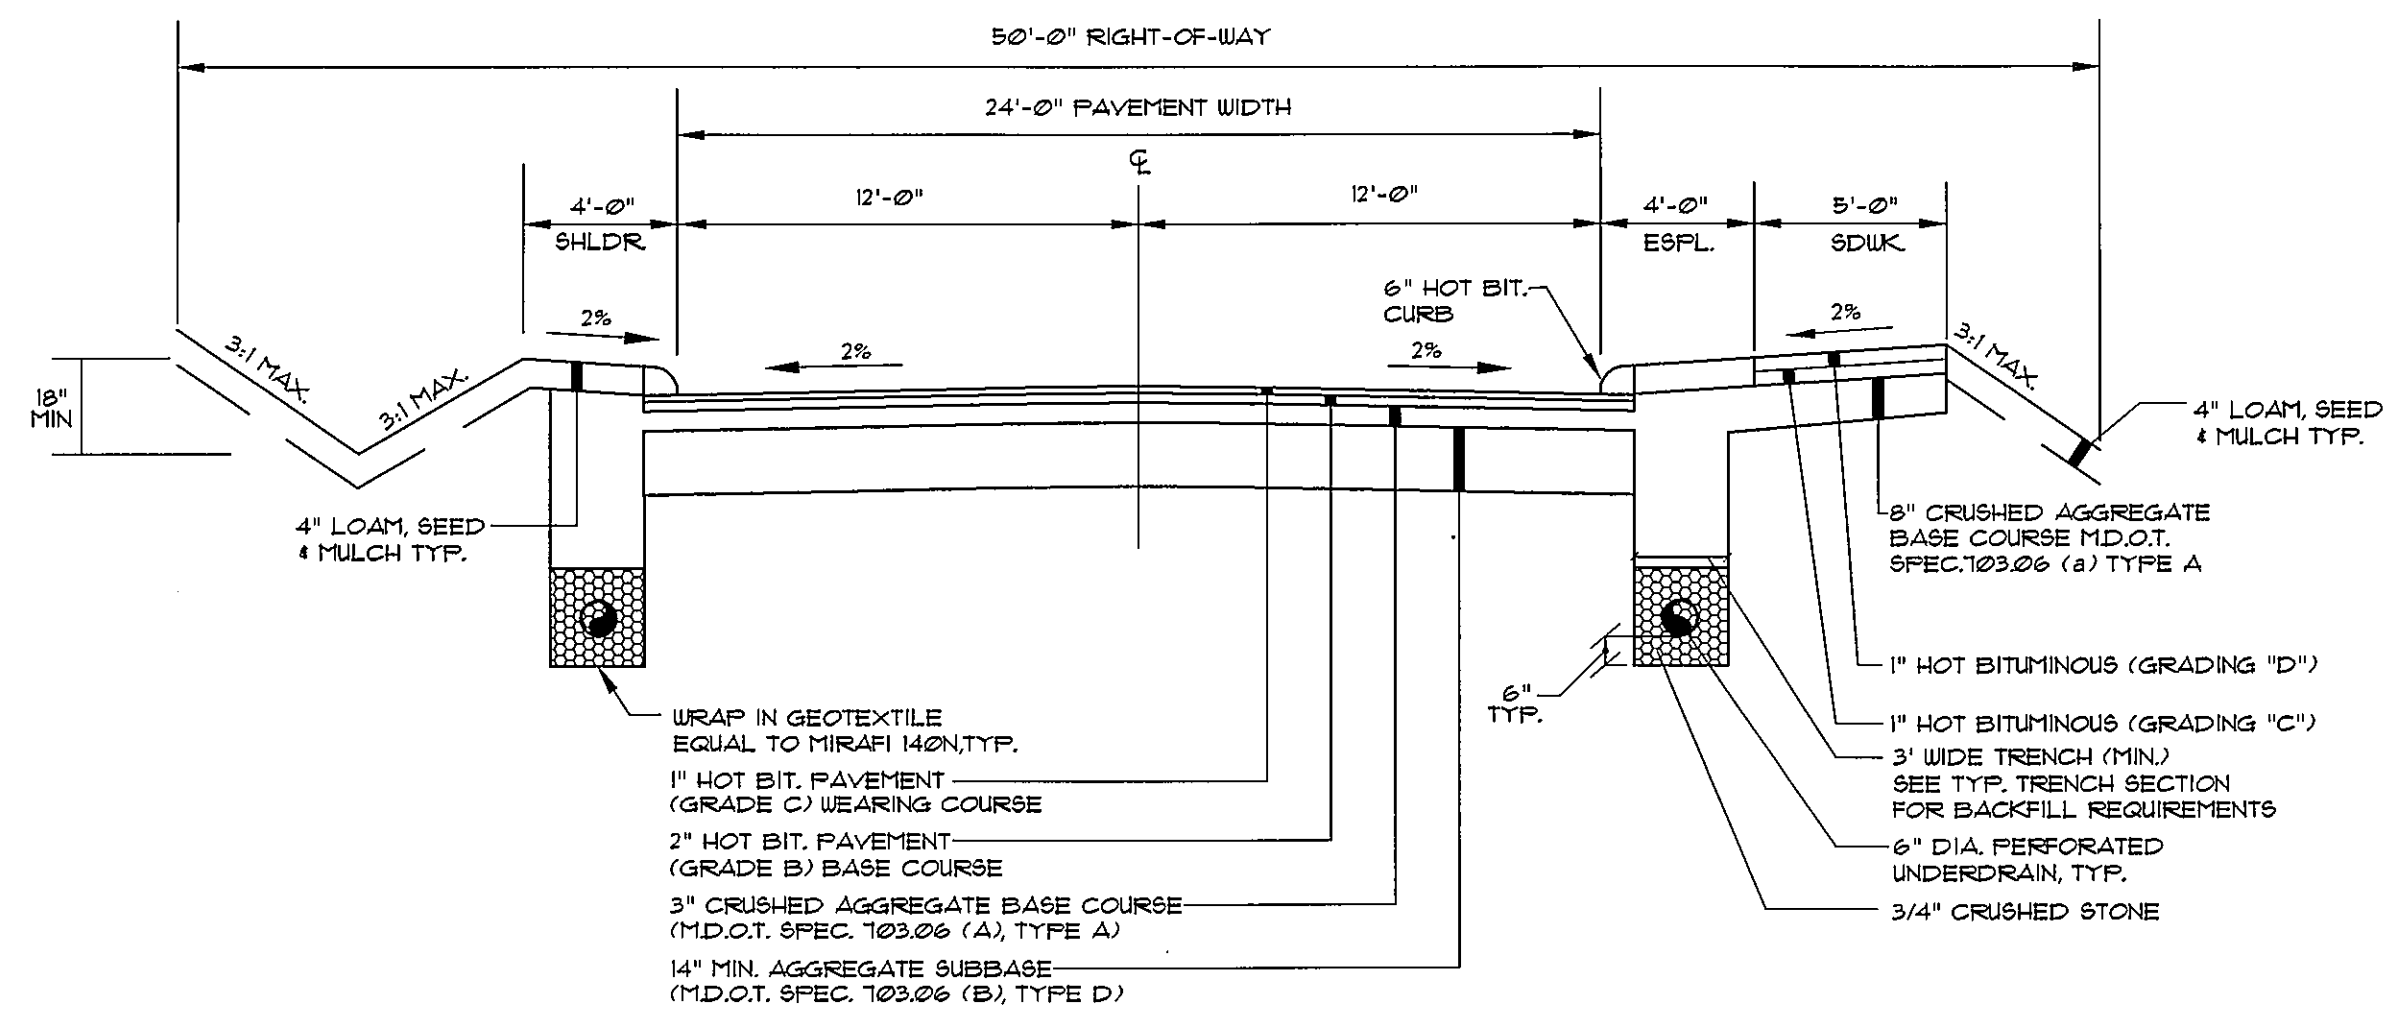

TYPICAL ROAD SECTION W/ ESPLANADE
 NOT TO SCALE

STATE OF MAINE
 RECEIVED _____ COUNTY SS REGISTRY OF DEEDS
 AT _____ h _____ m _____ M. AND RECORDED IN
 PLAN BOOK _____ PAGE _____
 ATTEST _____ REGISTRAR