


Approved by
 9/13/84 by
 " by White

AS-BUILT PLAN OF WENTWORTH RESORT Townhouse Condominium FOR MAI, INC

THIS PLAN IS A REPRESENTATION OF AS LOCATED ON THE DATES SHOWN PERMETER IN DIMENSIONS TO AND ALONG SINGL, OR SHEAT EVERY ASPECT OF THIS PLAN IS BASI OPINION THEREOF AS OF THE DATE OF SURV ANY GUARANTEES, TITLE OR OTHERWISE THIS

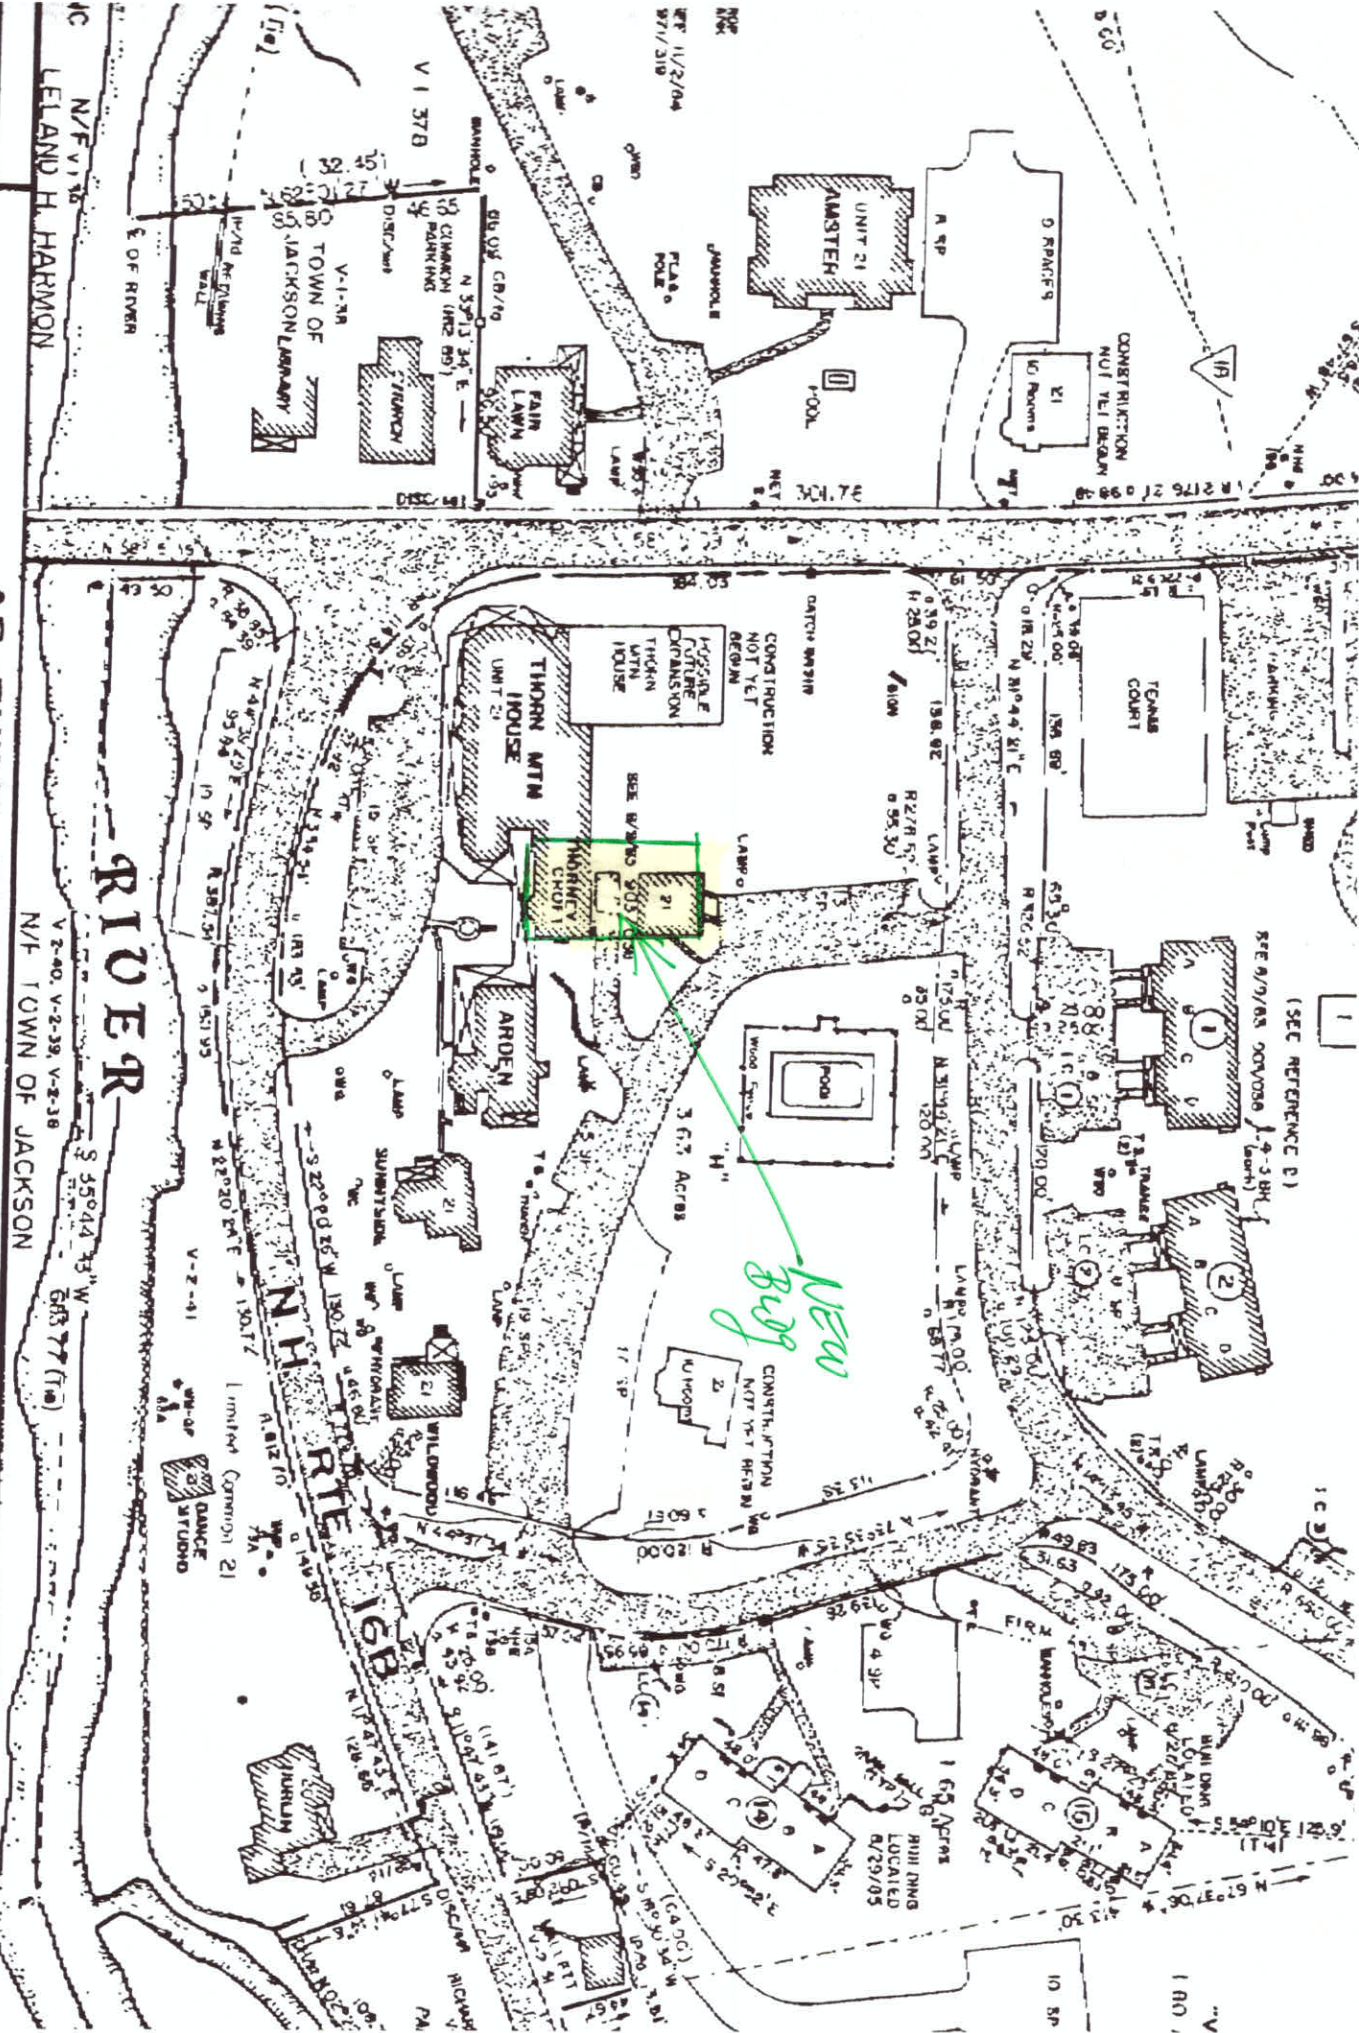

CEP