


A4343K-15
b

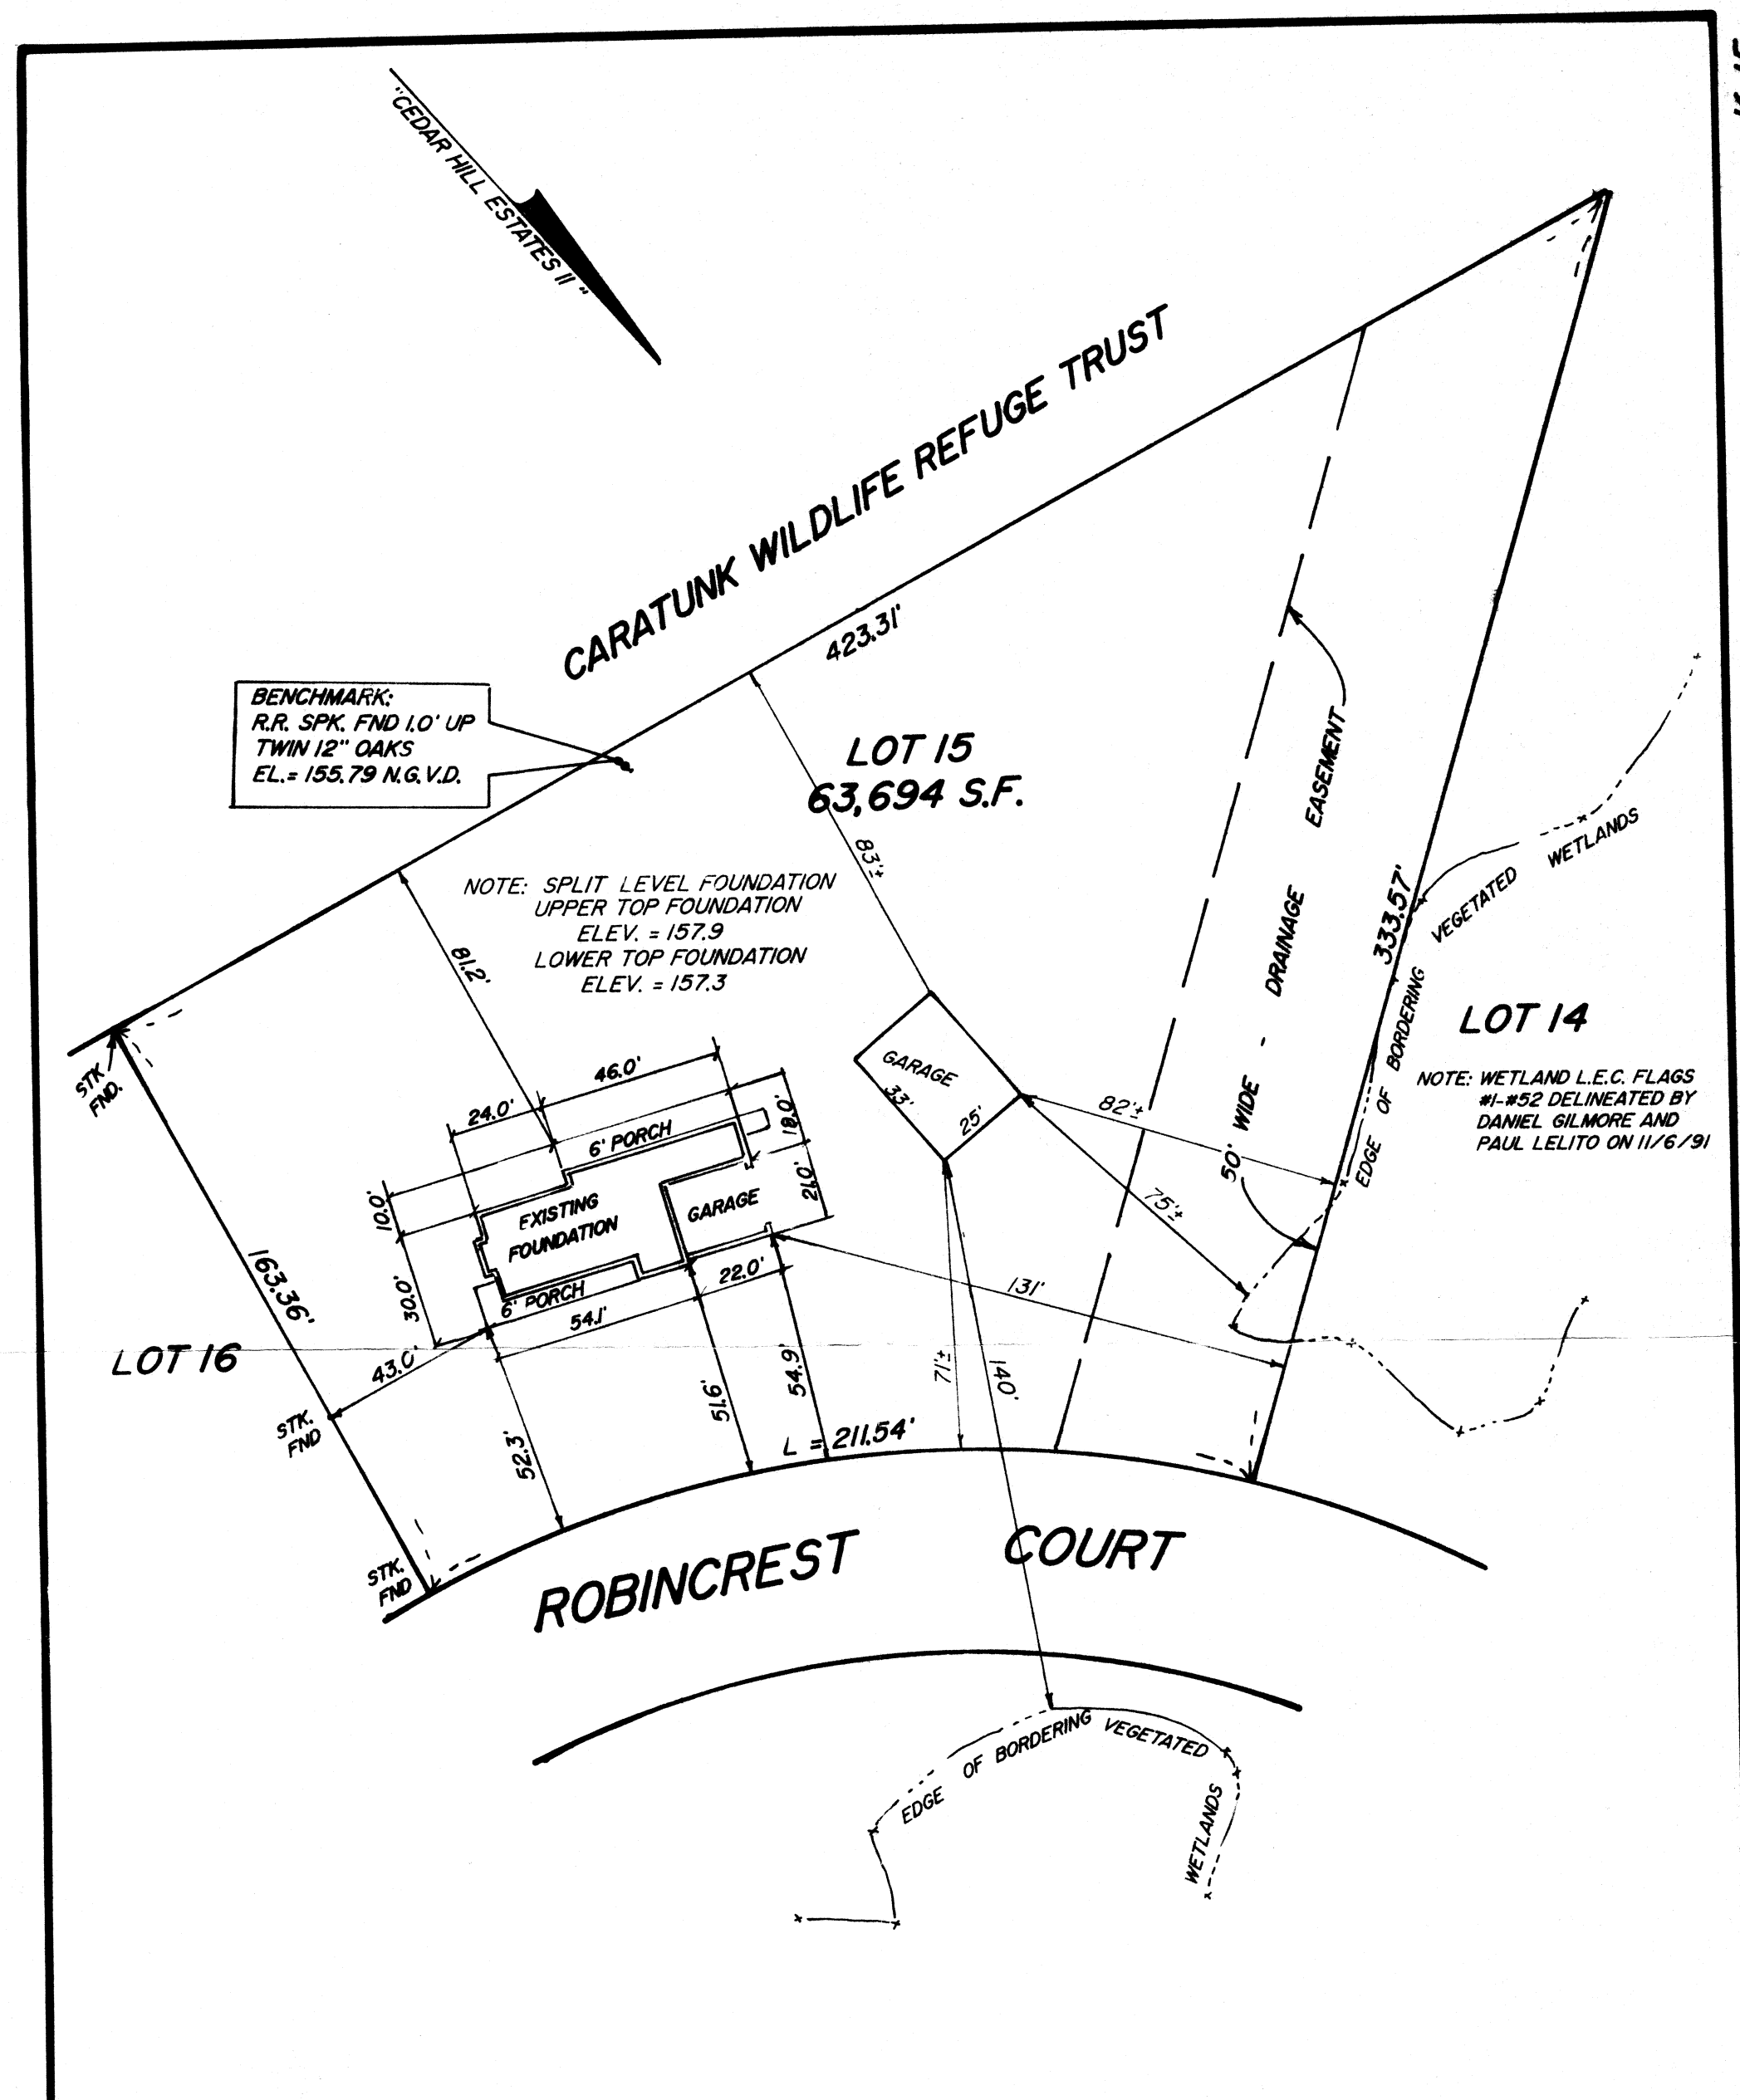

BENCHMARK:
R.R. SPK. FND 1.0' UP
TWIN 12" OAKS
E.L. = 155.79 N.G.V.D.

NOTE: SPLIT LEVEL FOUNDATION
UPPER TOP FOUNDATION
ELEV. = 157.9
LOWER TOP FOUNDATION
ELEV. = 157.3

LOT 14
NOTE: WETLAND L.E.C. FLAGS
#1-#52 DELINEATED BY
DANIEL GILMORE AND
PAUL LELITO ON 11/6/91


NOTE:

I CERTIFY THAT THE LOCATION
OF THE FOUNDATION SHOWN ON THIS
PLAN CONFORMS TO THE LOCAL ZONING LAWS

2.9.94 *James Williams*
DATE REGISTERED LAND SURVEYOR

ZONE: R-4

THIS PLAN PREPARED FOR:
BRUNO MAROVELLI

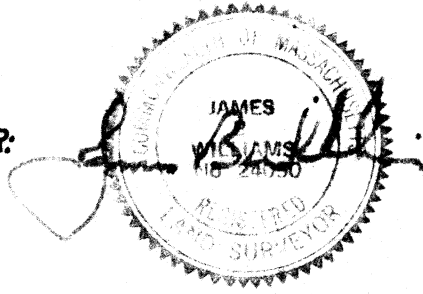

AS-BUILT 69-362
PLOT PLAN OF LAND IN
Seekonk, Massachusetts

SCALE 1" = 40'

FEBRUARY 7, 1994

FREEMAN ENGINEERING CO.
A DIVISION OF

HAYWARD - BOYNTON & WILLIAMS, INC.
LAND SURVEYORS CIVIL ENGINEERS
178 NORTH MAIN ST. ATTLEBORO, MASS.

REV. JANUARY 7, 1997
REV. FEBRUARY 13, 1997

NOTE: THIS PLAN NOT FOR RECORDING.

A4343K-15
1818
b