


IF THIS PLAN IS NOT SIGNED USING RED INK,
 STAMPED WITH A SEAL USING RED INK AND
 EMBOSSED IT IS AN UNAUTHORIZED REPRODUCTION
 AND INFORMATION SHOWN HEREON MAY NOT BE THE
 SAME AS ON THE ORIGINAL PLAN.

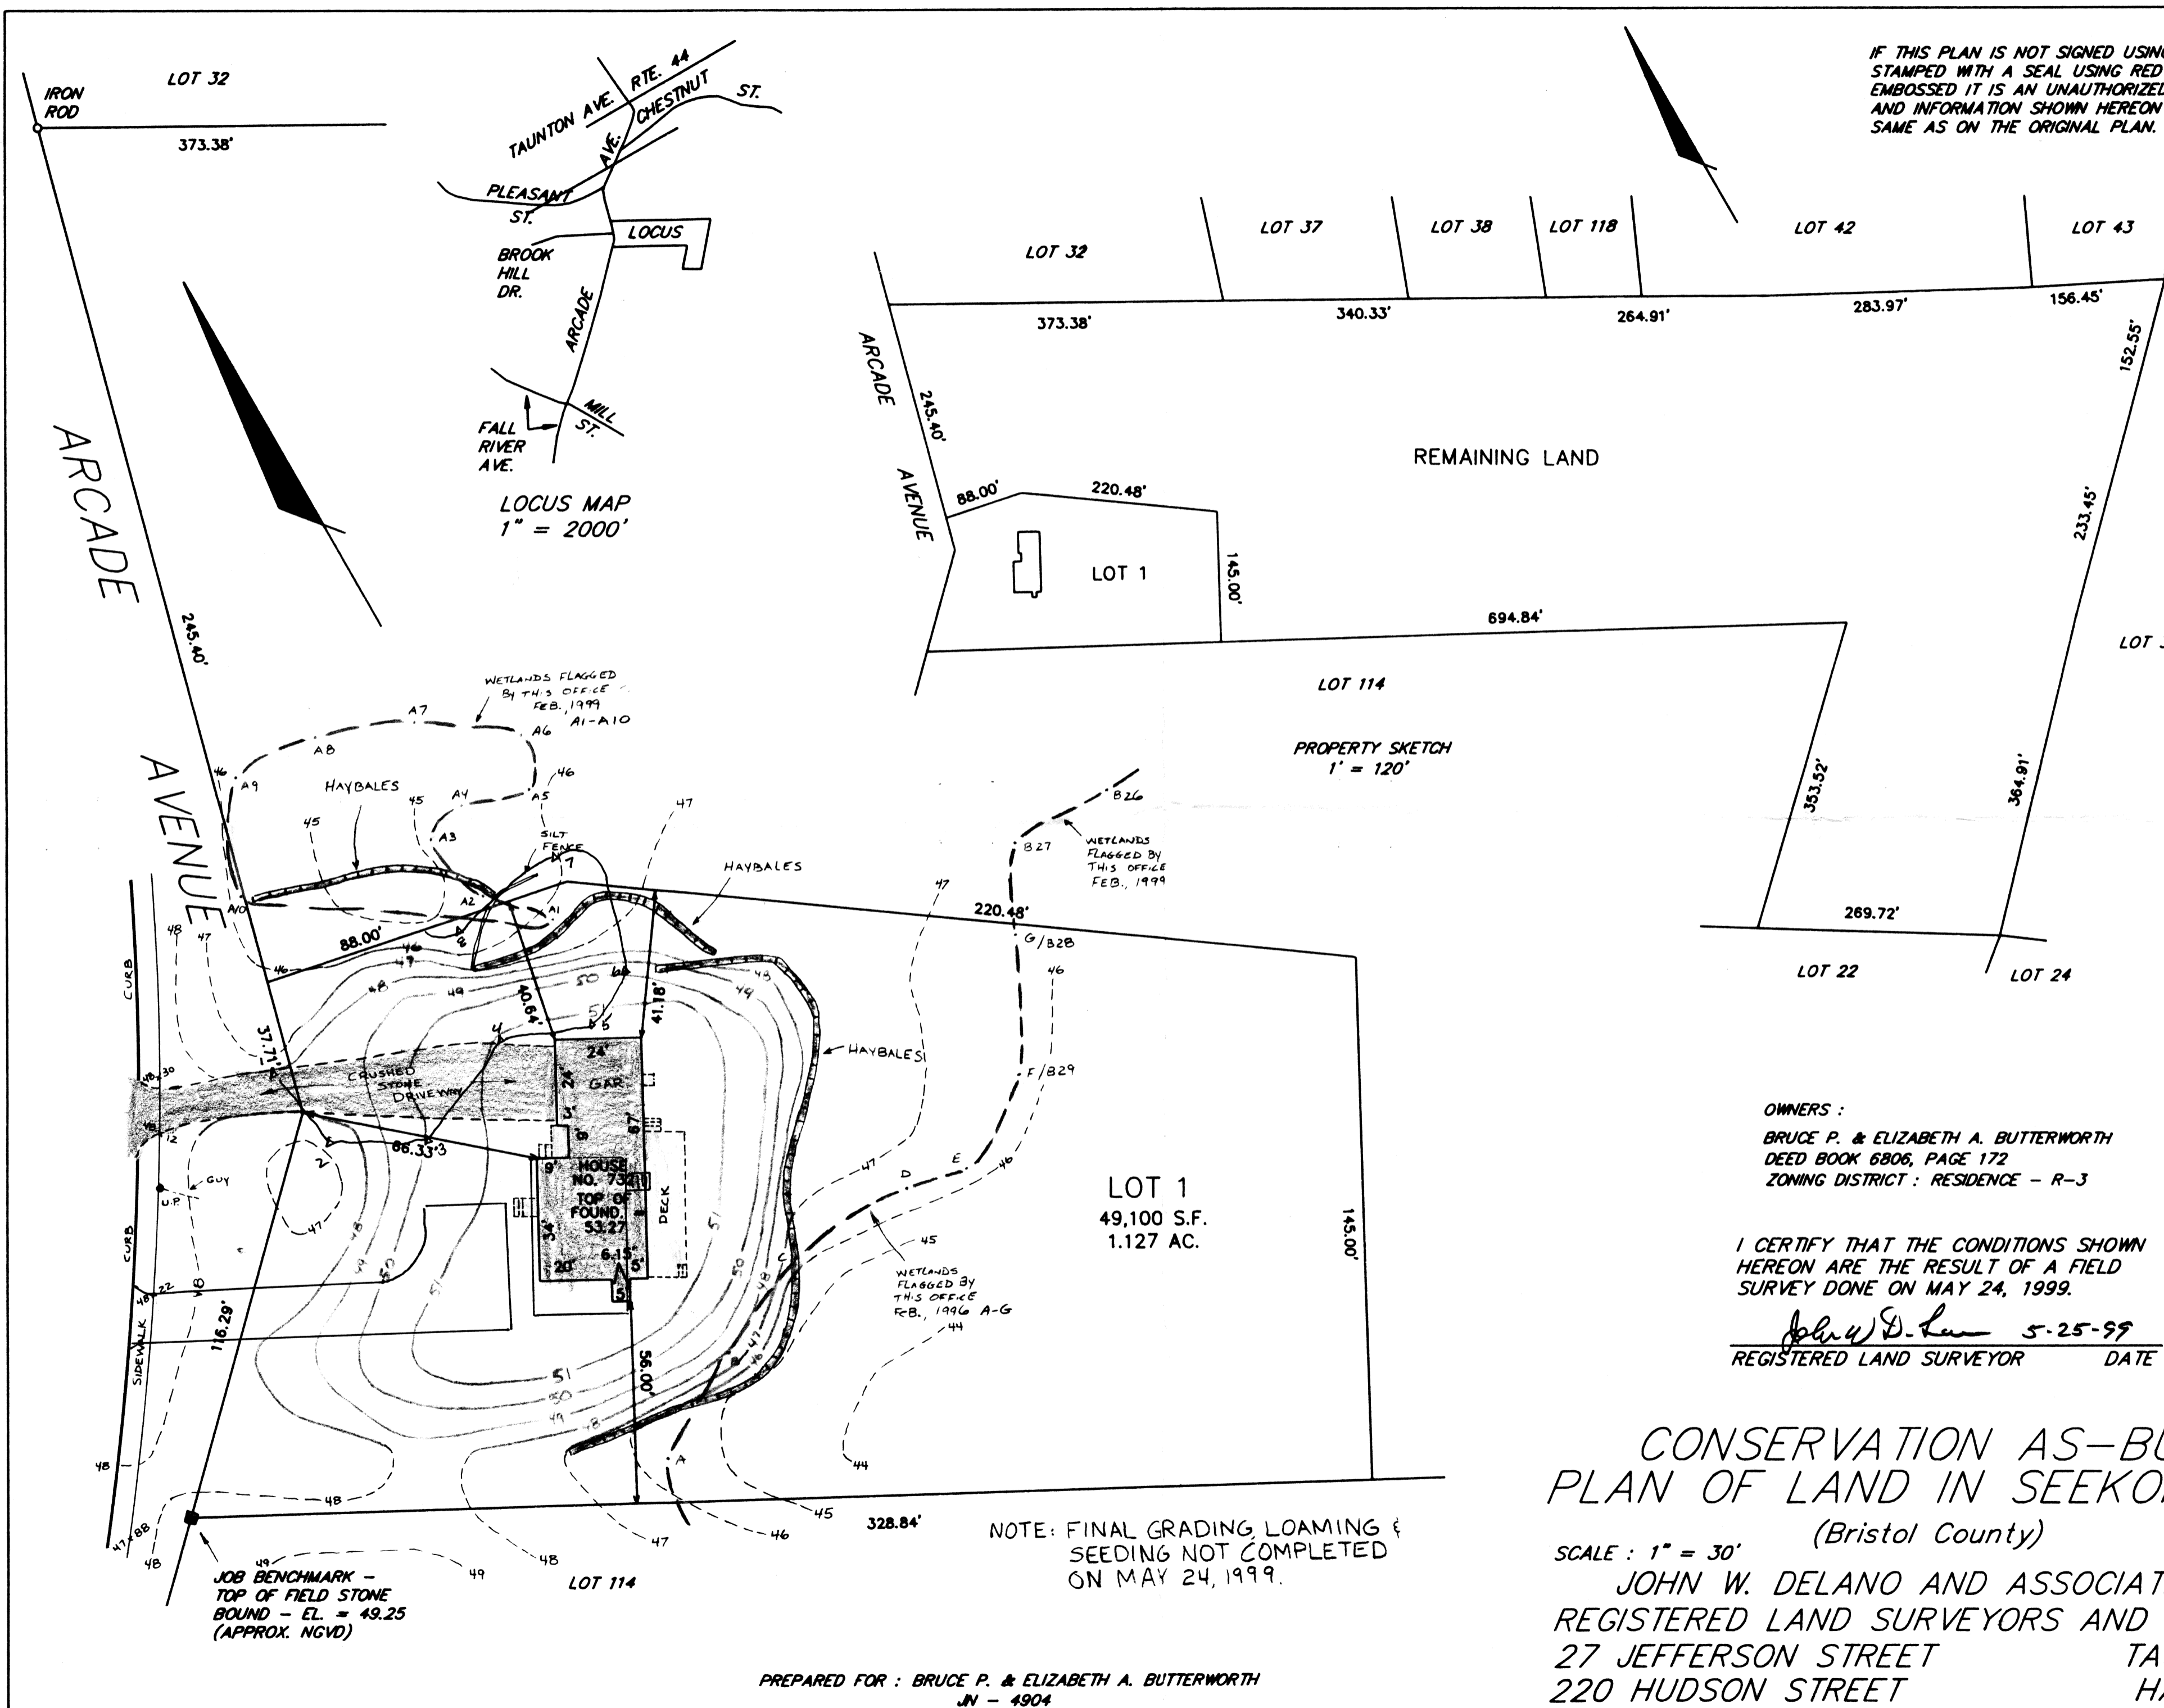

LOT 1
 49,100 S.F.
 1.127 AC.

PROPERTY SKETCH
 1" = 120'

LOCUS MAP
 1" = 2000'

NOTE: FINAL GRADING, LOAMING &
 SEEDING NOT COMPLETED
 ON MAY 24, 1999.

OWNERS :
 BRUCE P. & ELIZABETH A. BUTTERWORTH
 DEED BOOK 6806, PAGE 172
 ZONING DISTRICT : RESIDENCE - R-3

I CERTIFY THAT THE CONDITIONS SHOWN
 HEREON ARE THE RESULT OF A FIELD
 SURVEY DONE ON MAY 24, 1999.

John W. DeLano 5-25-99
 REGISTERED LAND SURVEYOR DATE



CONSERVATION AS-BUILT
 PLAN OF LAND IN SEEKONK, MA

(Bristol County)

SCALE : 1" = 30'
 MAY 25,
 JOHN W. DELANO AND ASSOCIATES, INC.
 REGISTERED LAND SURVEYORS AND ENGINEERS
 27 JEFFERSON STREET TAUNTON,
 220 HUDSON STREET HALIFAX, MA

PREPARED FOR : BRUCE P. & ELIZABETH A. BUTTERWORTH
 JN - 4904

JOB BENCHMARK -
 TOP OF FIELD STONE
 BOUND - EL. = 49.25
 (APPROX. NGVD)