
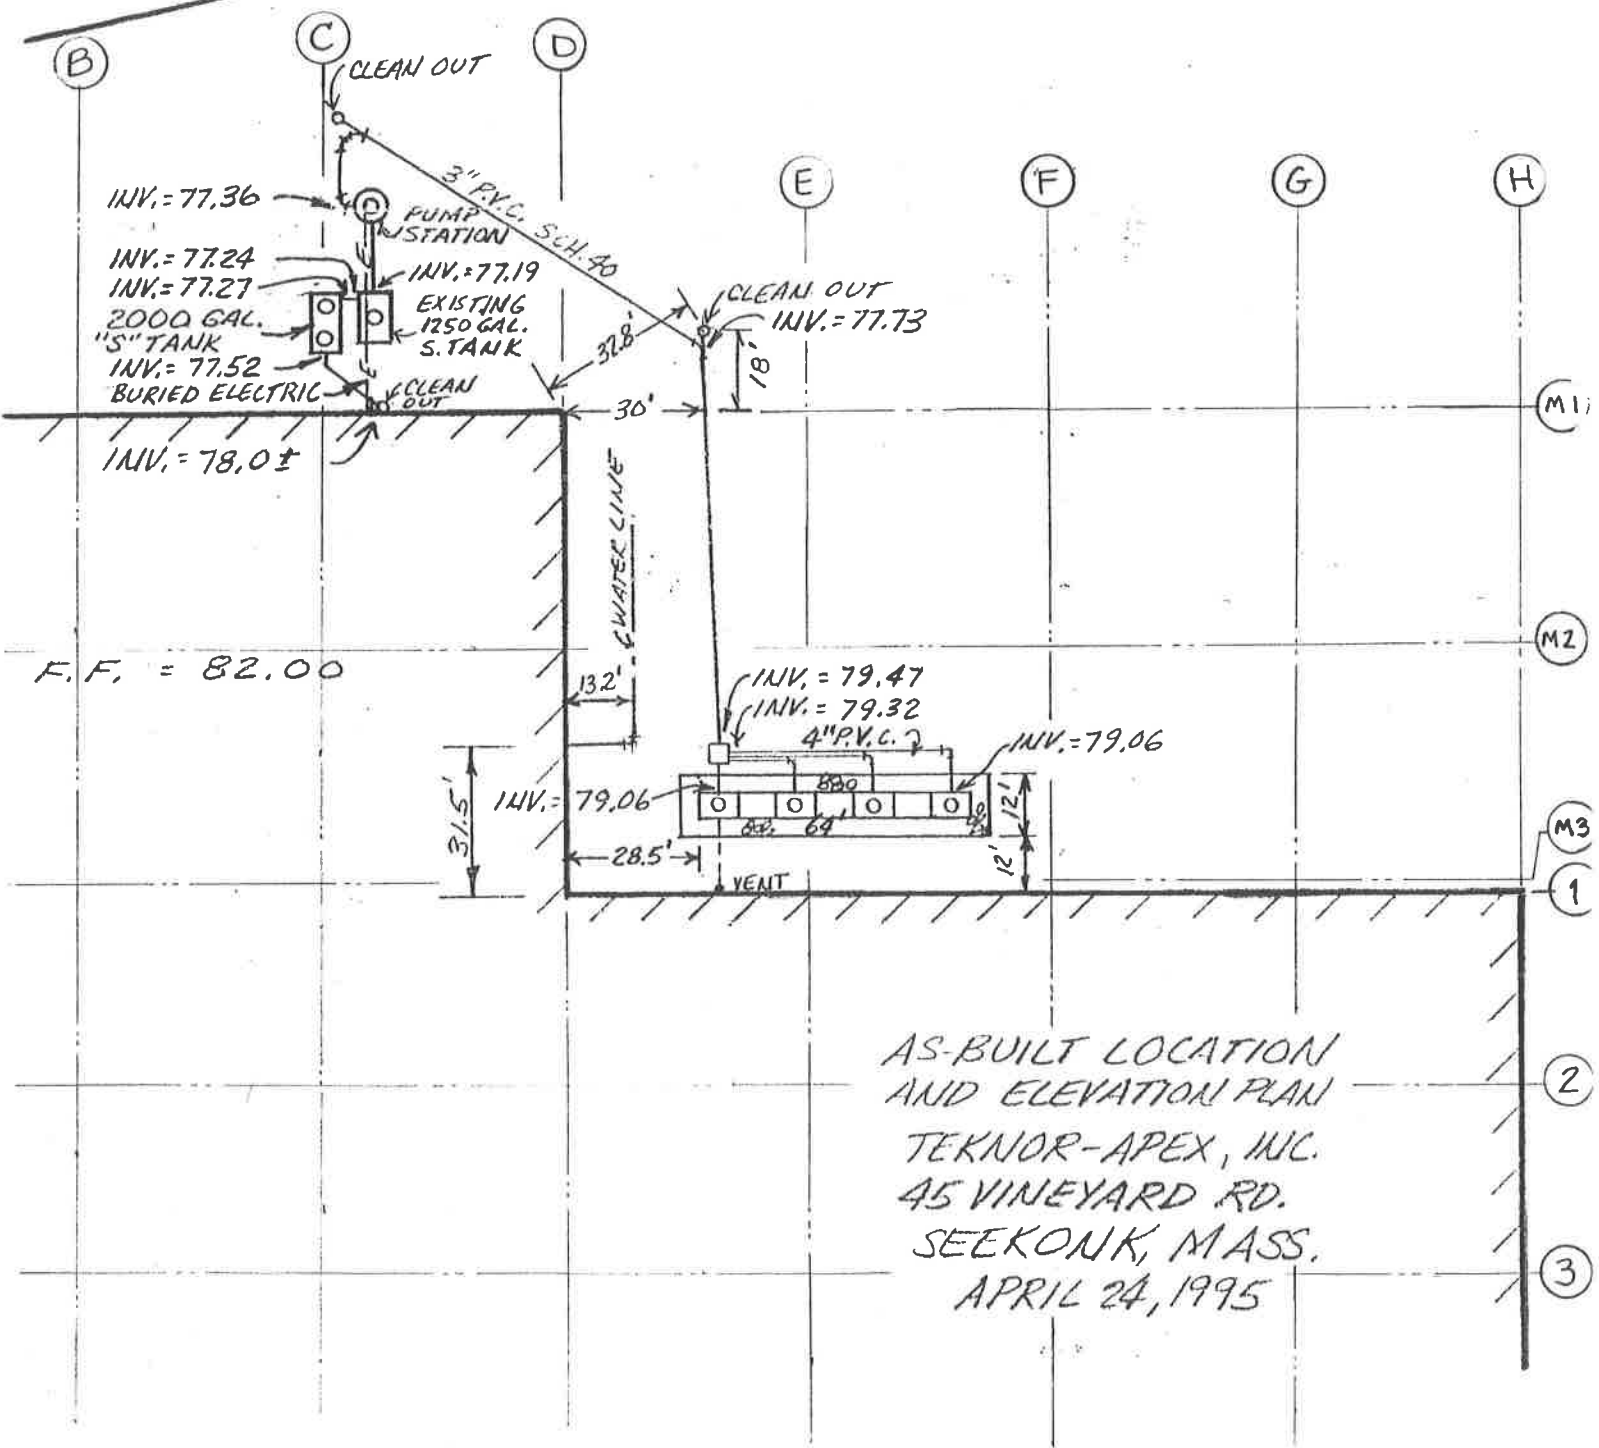


VINEYARD ROAD

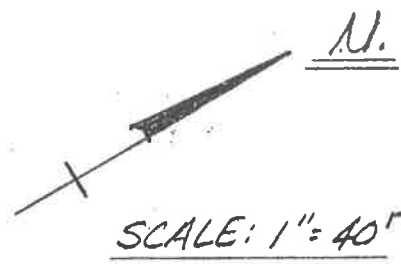

AS-BUILT LOCATION
AND ELEVATION PLAN
TEKNOR-APEX, INC.
45 VINEYARD RD.
SEEKONK, MASS.
APRIL 24, 1995