

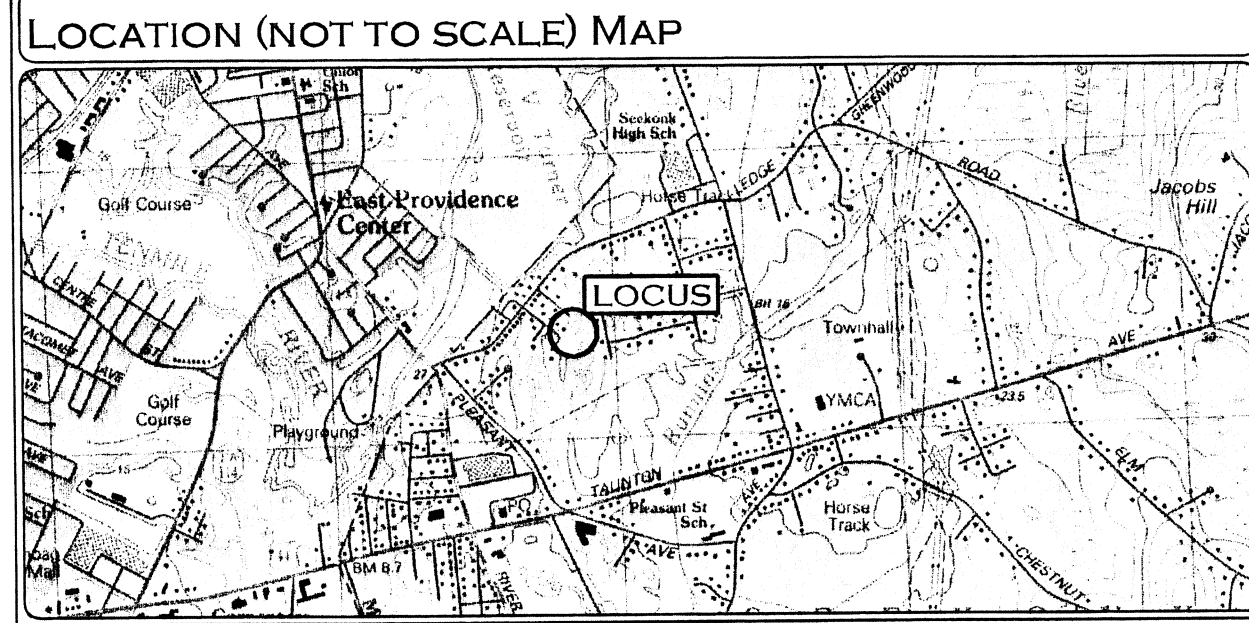
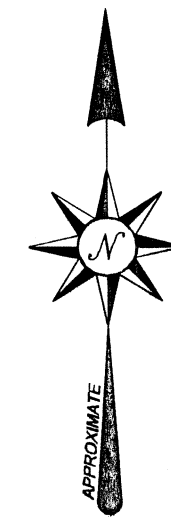


AP 20 LOT 594
 JOAO & MARIA ANDRADE
 48 QUARRY STREET
 SEEKONK, MA. 02771
 AREA = 53,547 Sq.Ft.

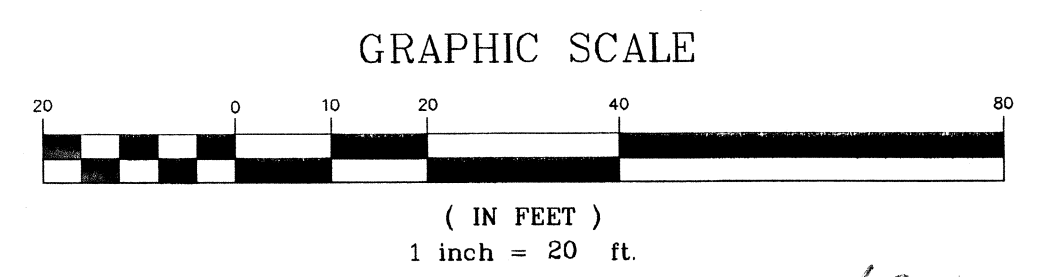


NOTES:

1. OWNERS: JOAO & MARIA ANDRADE
48 QUARRY STREET
SEEKONK, MA 02771
2. ASSESSORS DESIGNATION - MAP 20 LOT 594
3. PLAN REFERENCE:
 "AS-BUILT PLAN FOR QUARRY STREET ON LOT 594; BY MILLER ENGINEERING; DATED AUGUST 2, 2003."
 "PROPOSED HOUSE CONSTRUCTION AND STREET IMPROVEMENT PLAN LOT 594, QUARRY STREET SEEKONK, MA; BY MILLER ENGINEERING; DATED AUGUST 15, 2000."

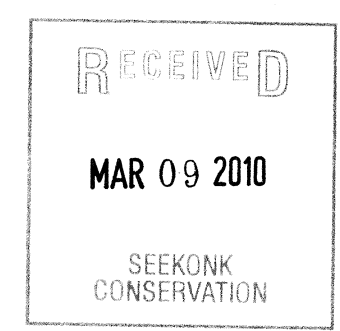


69-441

CERTIFICATE OF COMPLIANCE PLAN

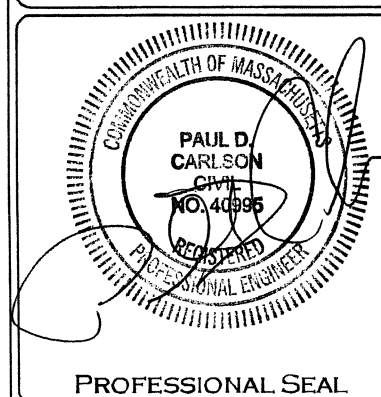

"QUARRY STREET"
 48 QUARRY STREET, SEEKONK, MASSACHUSETTS 02771
 ASSESSORS MAP 20 LOT 594
 Applicant: **JOAO & MARIA ANDRADE**
 48 QUARRY STREET, SEEKONK, MASSACHUSETTS 02771
 Job # 09-112 Scale: 1"=20' Drawn By: CEA Date: JANUARY 14, 2010
 Revised: MARCH 5, 2010

PROFESSIONAL SEAL

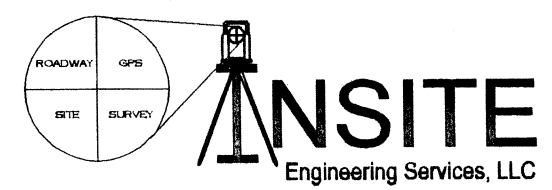

PROFESSIONAL ENGINEERS
 AND LAND SURVEYORS
 INSITE PROFESSIONAL COMPLEX, SUITE 1
 1539 FALL RIVER AVENUE
 SEEKONK, MA 02771
 PHONE: (508) 336-4500
 FAX: (508) 336-4558

SHEET
1
OF 1