


Gail
For you Files

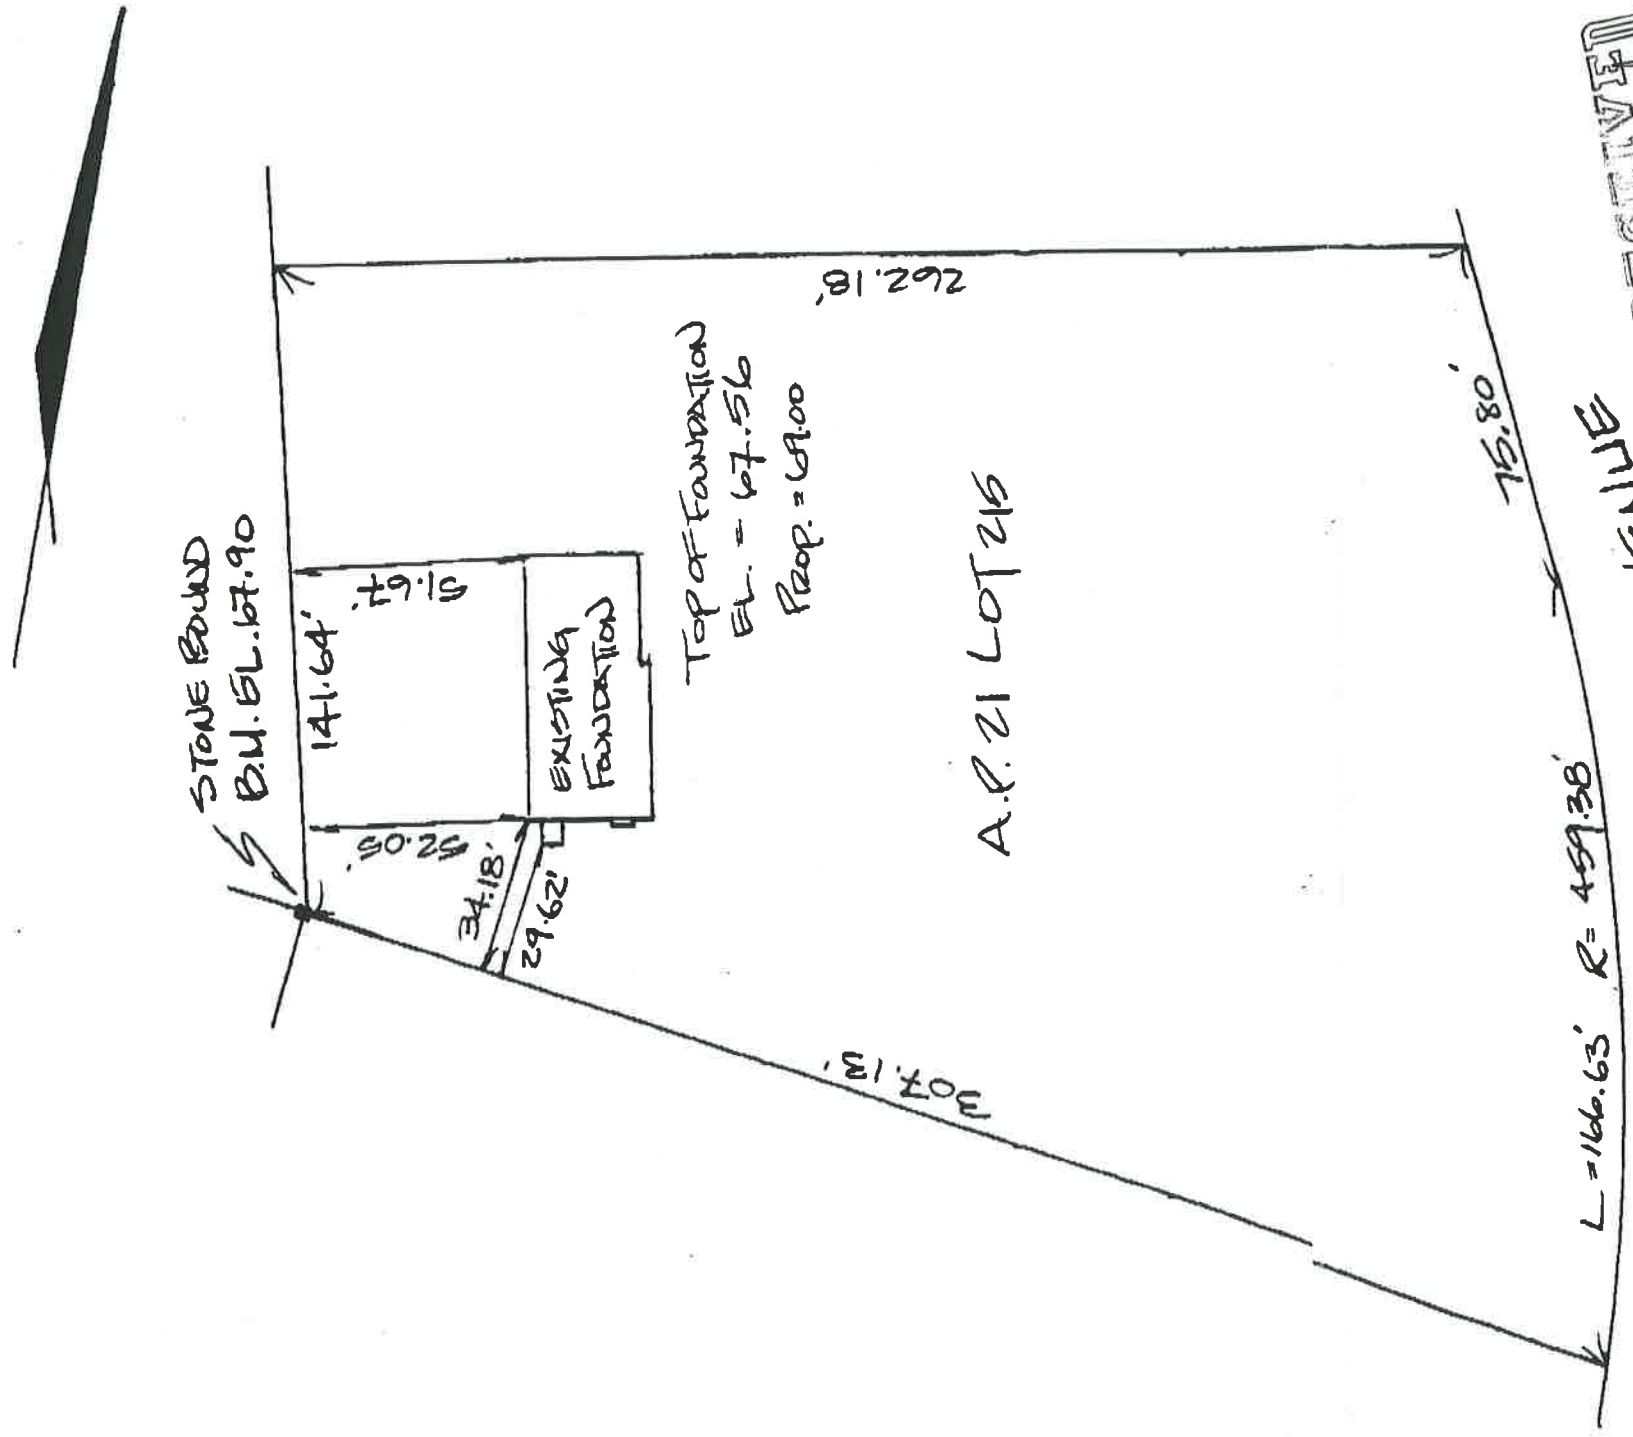

RECEIVED
NOV 24 1999
BY: [Signature]

TOWN OF SEEKONK
Date 11/24/99
Approved [Signature]
BLDG. INSPECTOR

69-408

AS-BUILT FOUNDATION PLAN
37 SHERMAN AVENUE
SEEKONK, MASSACHUSETTS

SCALE: 1" = 40'
NOV. 18, 1999
NOV. 24, 1999

PREPARED FOR
DUGALLY CONTRACTING, INC.
PREPARED BY

B.R. MCGEE & ASSOCIATES
71 FALL RIVER AVENUE
REHOBOTH, MA 02769
508-336-4500



[Signature]
11-24-99