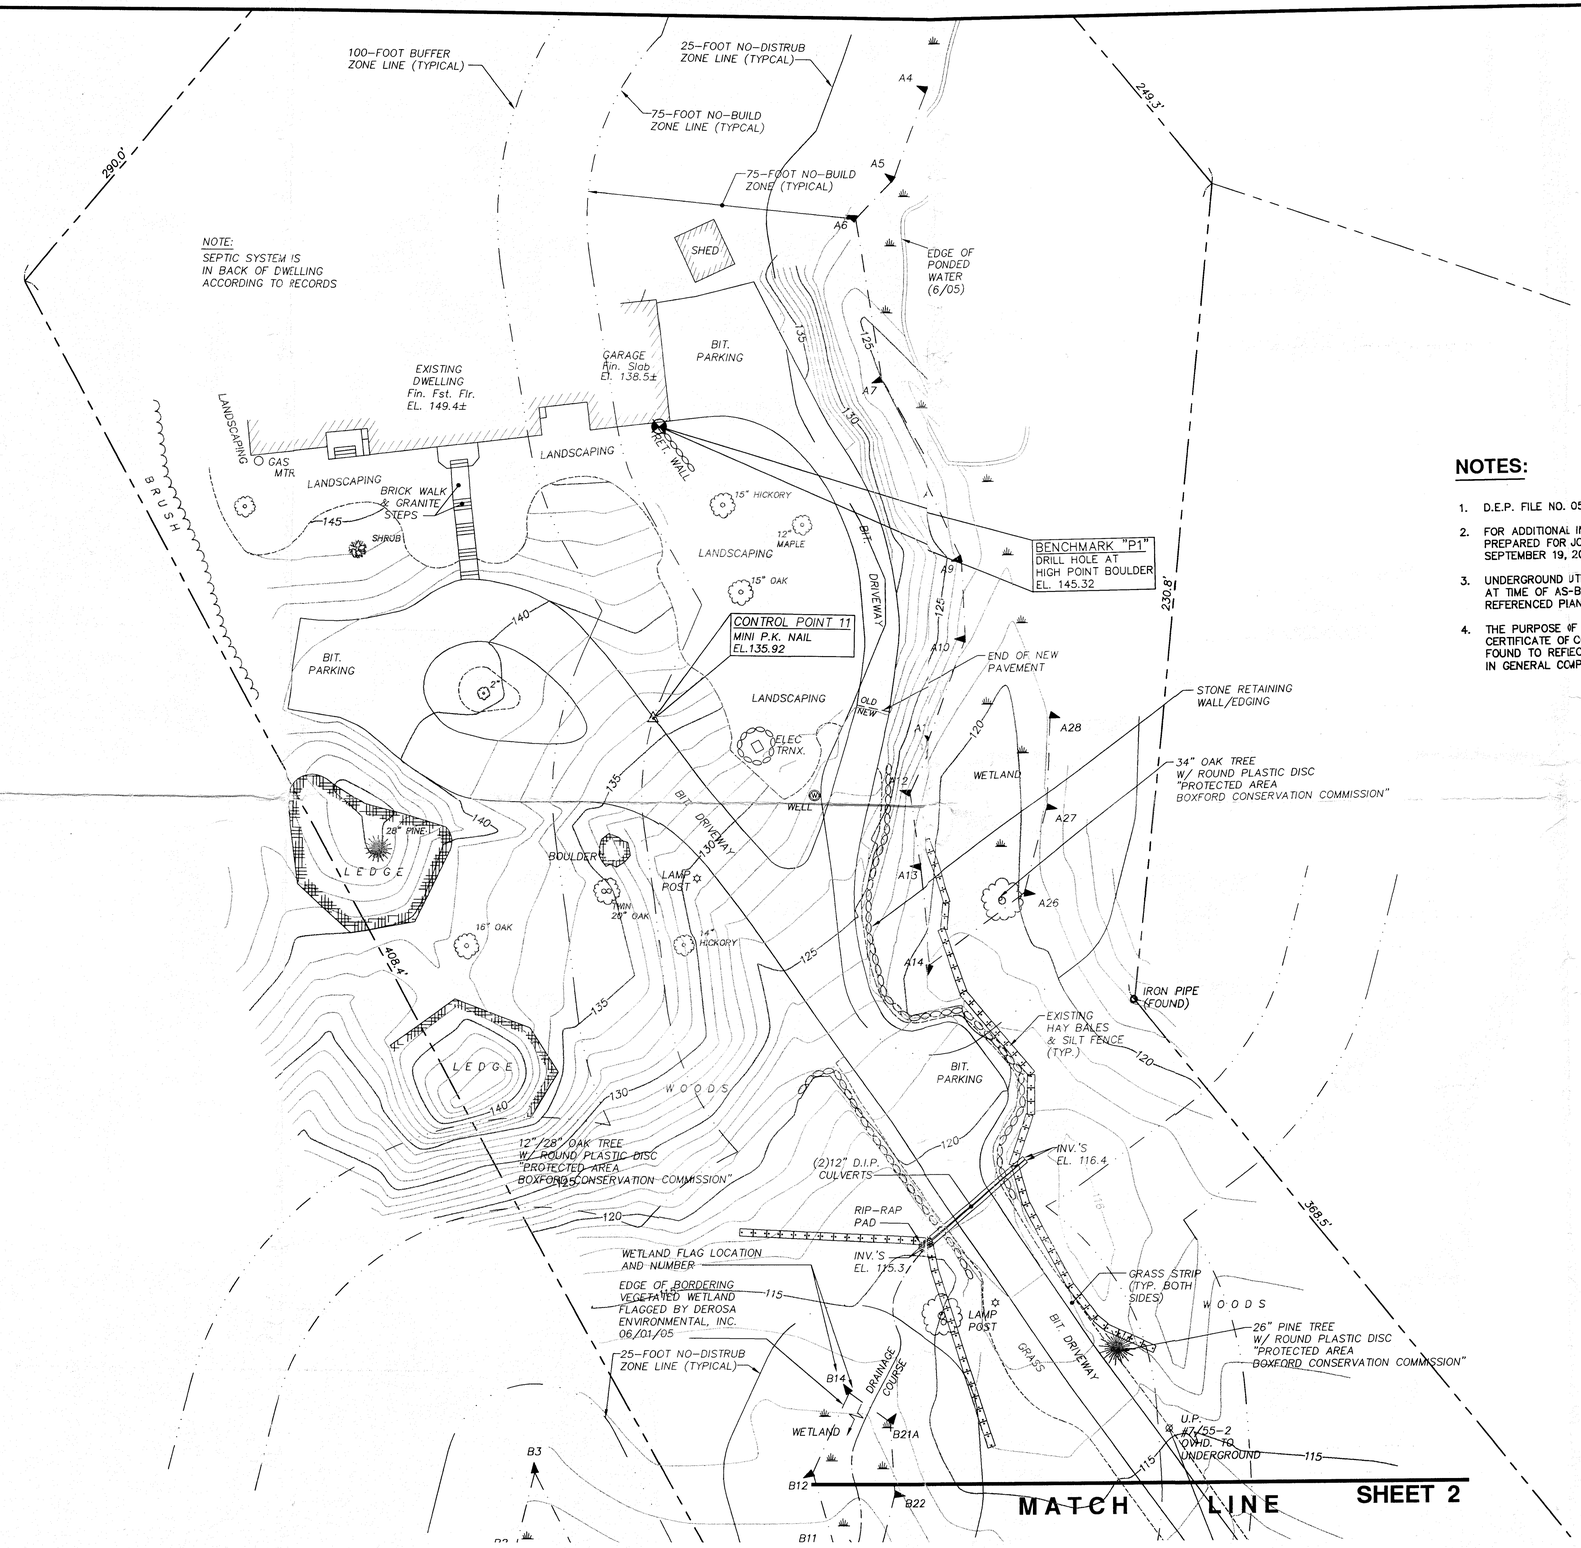

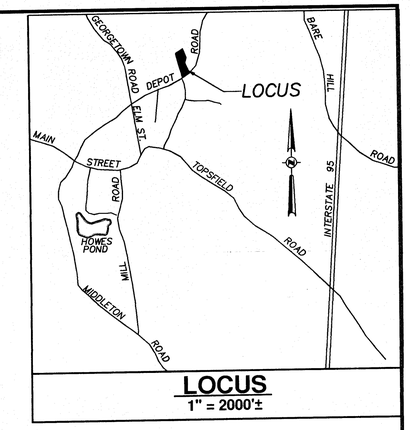

LOCUS
1" = 2000'±

NOTES:

1. D.E.P. FILE NO. 05-1040.
2. FOR ADDITIONAL INFORMATION, SEE "PLAN TO ACCOMPANY A NOTICE OF INTENT FILING PREPARED FOR JOHN POWELL", DATED JUNE 30, 2005 AND REVISED THROUGH SEPTEMBER 19, 2005 PREPARED BY H.L. GRAHAM ASSOCIATES, INC., 2 SHEETS.
3. UNDERGROUND UTILITIES NOT SHOWN ON THIS PLAN AND WERE NOT MARKED IN FIELD AT TIME OF AS-BUILT SURVEY. FOR INFORMATION ABOUT SAME SEE THE ABOVE REFERENCED PLAN.
4. THE PURPOSE OF THIS PLAN IS TO DEPICT RECORD/AS-BUILT CONDITIONS FOR A CERTIFICATE OF COMPLIANCE REQUEST. THE RECORD/AS-BUILT CONDITIONS WERE FOUND TO REFLECT THE INTENT AND PURPOSE OF, AND TO HAVE BEEN CONSTRUCTED IN GENERAL COMPLIANCE WITH, THE ABOVE REFERENCE PLAN.

SCALE IN FEET
20 10 0 20 40

RECORD PLAN
to accompany a
CERTIFICATE OF COMPLIANCE request
prepared for
JOHN POWELL

38 DEPOT ROAD — BOXFORD, MA.

GRAHAM ASSOCIATES, INC.
CIVIL ENGINEERS
TWO CENTRAL STREET, IPSWICH, MA 01938 (978) 356-2756

DRAWN BY: JC/HCT	CHECKED BY: HLG	PROJECT NO.:05-515
DATE: NOV. 28, 2006	SCALE: 1" = 20'	SHEET 1 OF 2