


Menemsha Market
511 North Road Road
Menemsha, Ma 02552
(508) 645-3501

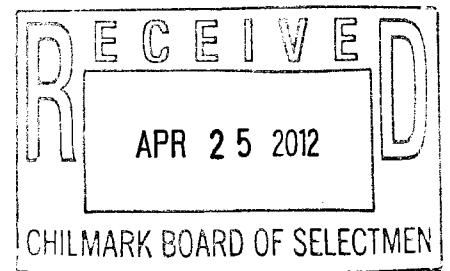

~ Common Victuallar License

Manager: Debbie Packer

Open seasonally

Hours of operation could be as much as 7 days a week 7am-9pm

Will have as many as 4 employees or as needed in July and August

Menemsha Market~ originally Carl Reeds Store built 1924

Sewards purchased the store in 1946 Name was Bill's Seagoing Grocery

1970~1980 Seward's Market

1980~to date: owned by Dorothy Packer she named it Menemsha Market

The Menemsha Creek Post Office was moved to the store e in the early 30's
and was moved to the Chilmark Post Office in about 1999.

Survived the 38, 44, 54 Hurricanes

Menemsha Market would like to continue to serve it's community.

Menemsha Market will be run in the same spirit that it has been through it's years. It will be threw new eyes and hearts, blending with all that came before.

Menemsha Market a store for the locals, summer residence, boaters, bikers, tourists and others. The market will continue to employ as part of the employe base, the local youth. Thus providing income and education and to teach us. The young people are able work for themselves, their community, find their voice and learn skills for their future as well as to help guide us to their needs.

~Their will be no Wii and patrons will be invited not to use their cell phones or smoke in market, or porch out of respect to other patrons as well as to preserve the hysteric charm of the front porch social space that is dear to us here in Menemsha.

~As our community contuse to voices it's concerns about our waters and pond, the vision of the market being a resource to educate and increasing awareness about the preservation of our water, land, animals, fisherman, farmers and local charm.

~The vision of the Harbor Safe Products Project will help to reduce the levels of nitrogen being dumped directly into our waters and thus helping in the healing of our ponds and ocean and all life, thus sporting life and livelihood.

Menemsha Market is aiming to sell the following:

Produce

Health And Body Care (HABA)

Frozen Food

Refrigerated Foods and Drinks

General Groceries

Newspapers and Magazines

Ice

Water

Cigarettes & Cigars

Environmentally Respectful Cleaning Products

Batteries etc...

Gifts

Regional Food Products & Crafts


Coffee & Tea~a social cup

& Happiness for free.



VINEYARD LAND SURVEYING & ENGINEERING, INC.

12 Courmoyer Road, P.O. Box 421 West Tibury, MA 02575
P 508.693.3774 F 508.693.8575

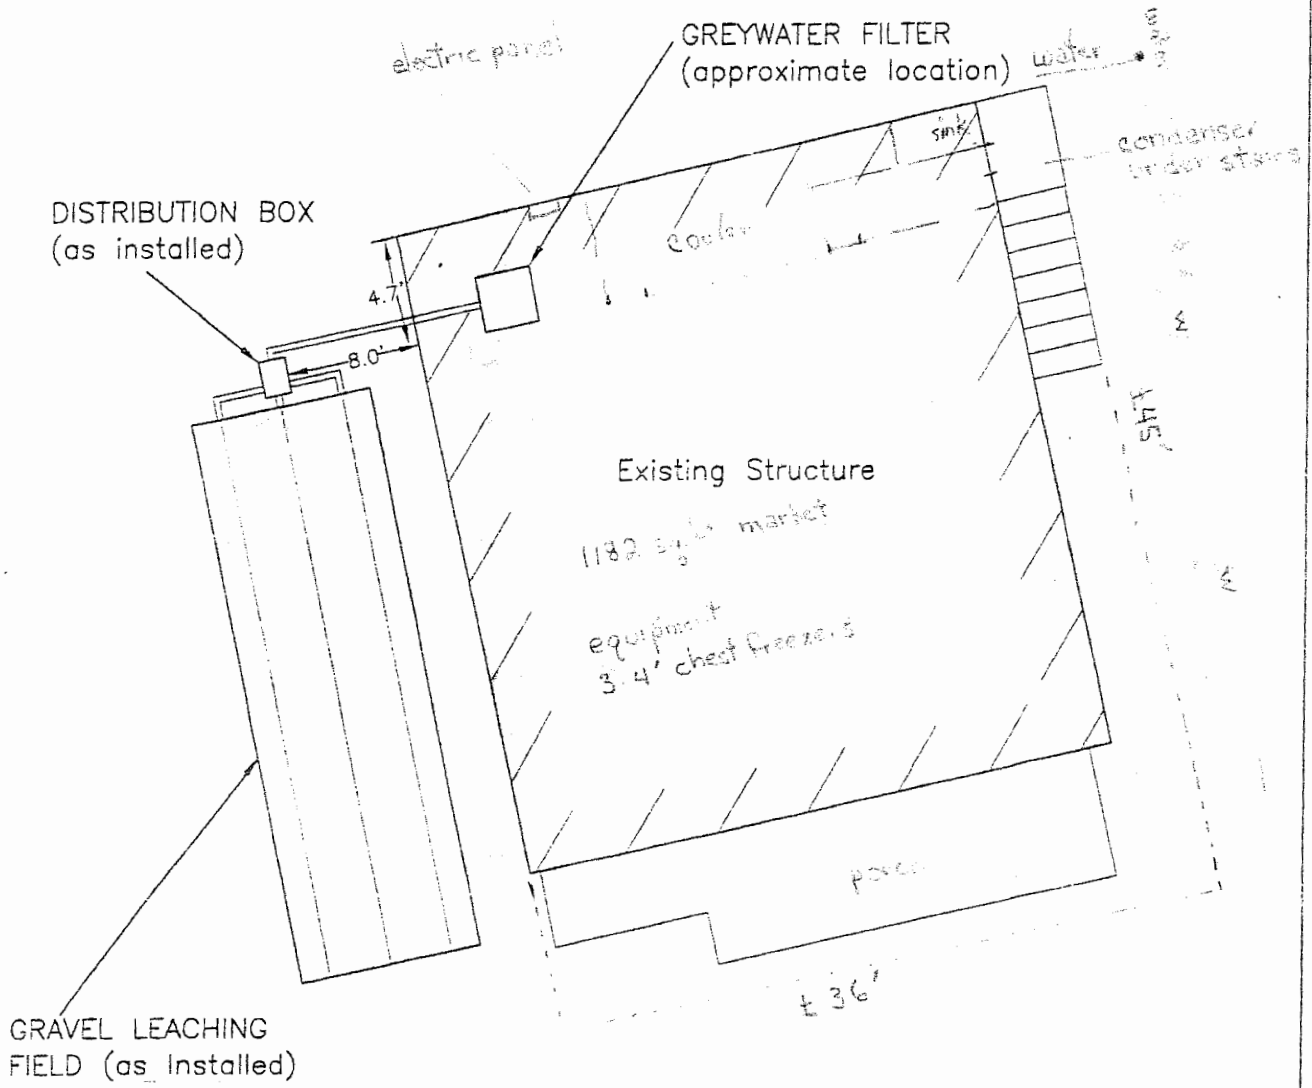

AS-BUILT SEPTIC SKETCH PLAN

PREPARED FOR: DOROTHY PACKER
 PROPERTY ADDRESS: #511 NORTH ROAD
 ASSR. PCL. 27.1-97
 SCALE: NO SCALE
 DATE: MAY 27, 2011

JOB NO. 1480