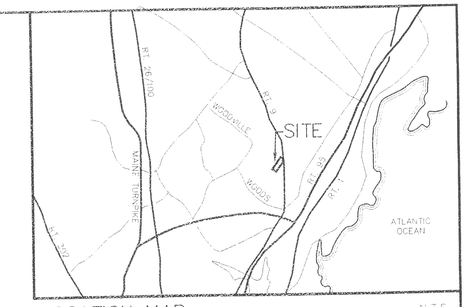

LOCATION MAP

N.T.S.

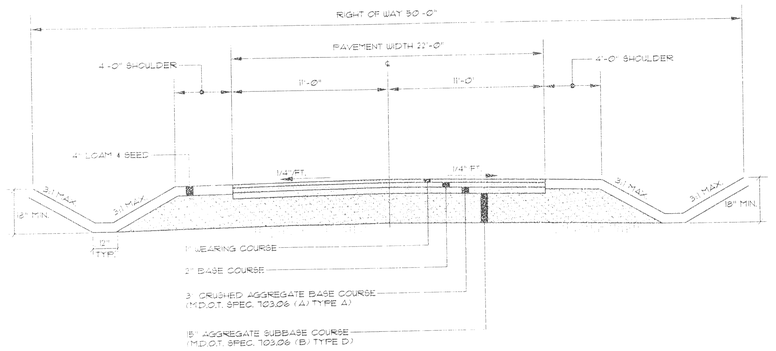

MINOR LOCAL STREET SECTION

SCALE: 1"=5'

CURVE DATA

CURVE	LENGTH	RADIUS	CRD BEARING	CRD. DIST.
C1	262.63'	250.00'	S56°12'25"W	250.72'
C2	122.82'	250.00'	N40°11'08"E	121.59'
C3	191.88'	250.00'	S32°16'18"W	187.21'
C4	279.52'	250.00'	S21°44'50"E	265.19'

LEGEND

AS-BUILT	DESCRIPTION	PROPOSED
	BUILDING	
	EDGE PAVEMENT	
	TREELINE	
130	CONTOURS	
	TRANSFORMER PAD	
	GATE VALVE	
	LIGHT POLE	
	HYDRANT	
W	WATER	W
	STORM DRAIN	
	BUFFER	
	UNDERGROUND ELEC. & TEL.	UGE 4T
	RIPRAP	
MBX	MAILBOX	
126.79	CENTERLINE ELEVATION	126.79
	WATER SHUT OFF	

REV:	BY:	DATE:	STATUS:
A	WPS	10/23/09	ADDED DRIVEWAY ENTRANCE & CULVERT, AND MAIL BOX

THIS PLAN SHALL NOT BE MODIFIED WITHOUT WRITTEN PERMISSION FROM SEBAGO TECHNICS, INC. ANY ALTERATIONS, AUTHORIZED OR OTHERWISE, SHALL BE AT THE USER'S SOLE RISK AND WITHOUT LIABILITY TO SEBAGO TECHNICS, INC.

Sebago Technics
Engineering Expertise You Can Build On
One Chabot Street
Westbrook, Me 04098-1339
Tel (207) 856-0277

PROJECT NO.	FIELD BOOK	DESIGN	CHKD	DRAWN
02482EC	2A	-	MWE	MCC

AS-BUILT PLAN
OF:
SHERMAN WOODS SUBDIVISION
ROUTE 9 (A.K.A. LONGWOODS DRIVE)
FALMOUTH, MAINE
FOR:
BERUBE BUILDERS, INC.
1040 PORTLAND ROAD, SUITE 2
SACO, MAINE 04072

DATE	SCALE
8/24/07	1"=40'

SHEET 2 OF 2

02482AB.dwg, TAB: AB-2