



Town of Lee
Field Irrigation System
Addendum #1 – May 28, 2013

This Addendum forms a part of the Contract Documents and modifies the original Contract Documents as described. Acknowledge receipt of this Addendum in the space provided on the Form of Proposal. Failure to do so may subject Bidder to disqualification. This Addendum is issued to all known Plan Holders.

This addendum consists of the following:

- 1) Proposals are **not** due May 29, 2013 at this time. This project is on hold until a determination is made regarding whether or not the proposal will proceed as a Design/Build or if the Town will provide an irrigation system design.
- 2) Additional documentation:
 - a. State of NH Water Well Report Date of completion 8/31/2009
 - b. Baseball Field Irrigation System As-built plan
- 3) Information provided at the site walk on May 20, 2013:
 - a. The total dimensions of the field to be constructed are 376' x 226';
 - b. the intent is to place +/- 12" loam and sod
 - c. the well pump is 5 hp
 - d. please provide a metal enclosure to house the controls
 - e. control wire can be 18 ga.

END OF ADDENDUM #1

Well Id (WRB#): **135.0696** [Well Completion Report](#)

Date Completed: **08/31/2009**

Name and Location: **TOWN OF LEE**
[Mapit](#) **RTE 155**
LITTLE RIVER PARK
LEE

Total Depth: **300 ft**

Depth to Bedrock: **17 ft**

Tax Map No: **20**

Casing: **42 ft**

Lot No: **2-1**

Tested Yield: **45 gal/min**

Type: **DRILLED IN BEDROCK**

Static Water Level: **5 ft**

Use: **AGRICULTURAL**

Special Note:

Well Driller

Driller License No: **364**


Driller Well Id: **364-09181**

Name and Address: **FAXON'S ARTESIAN WELLS & PUMPS**
81 HAMPSTEAD RD
SANDOWN NH 03873

Current License Status: **Inactive**


Email:

Phone Number: **603-887-8169**

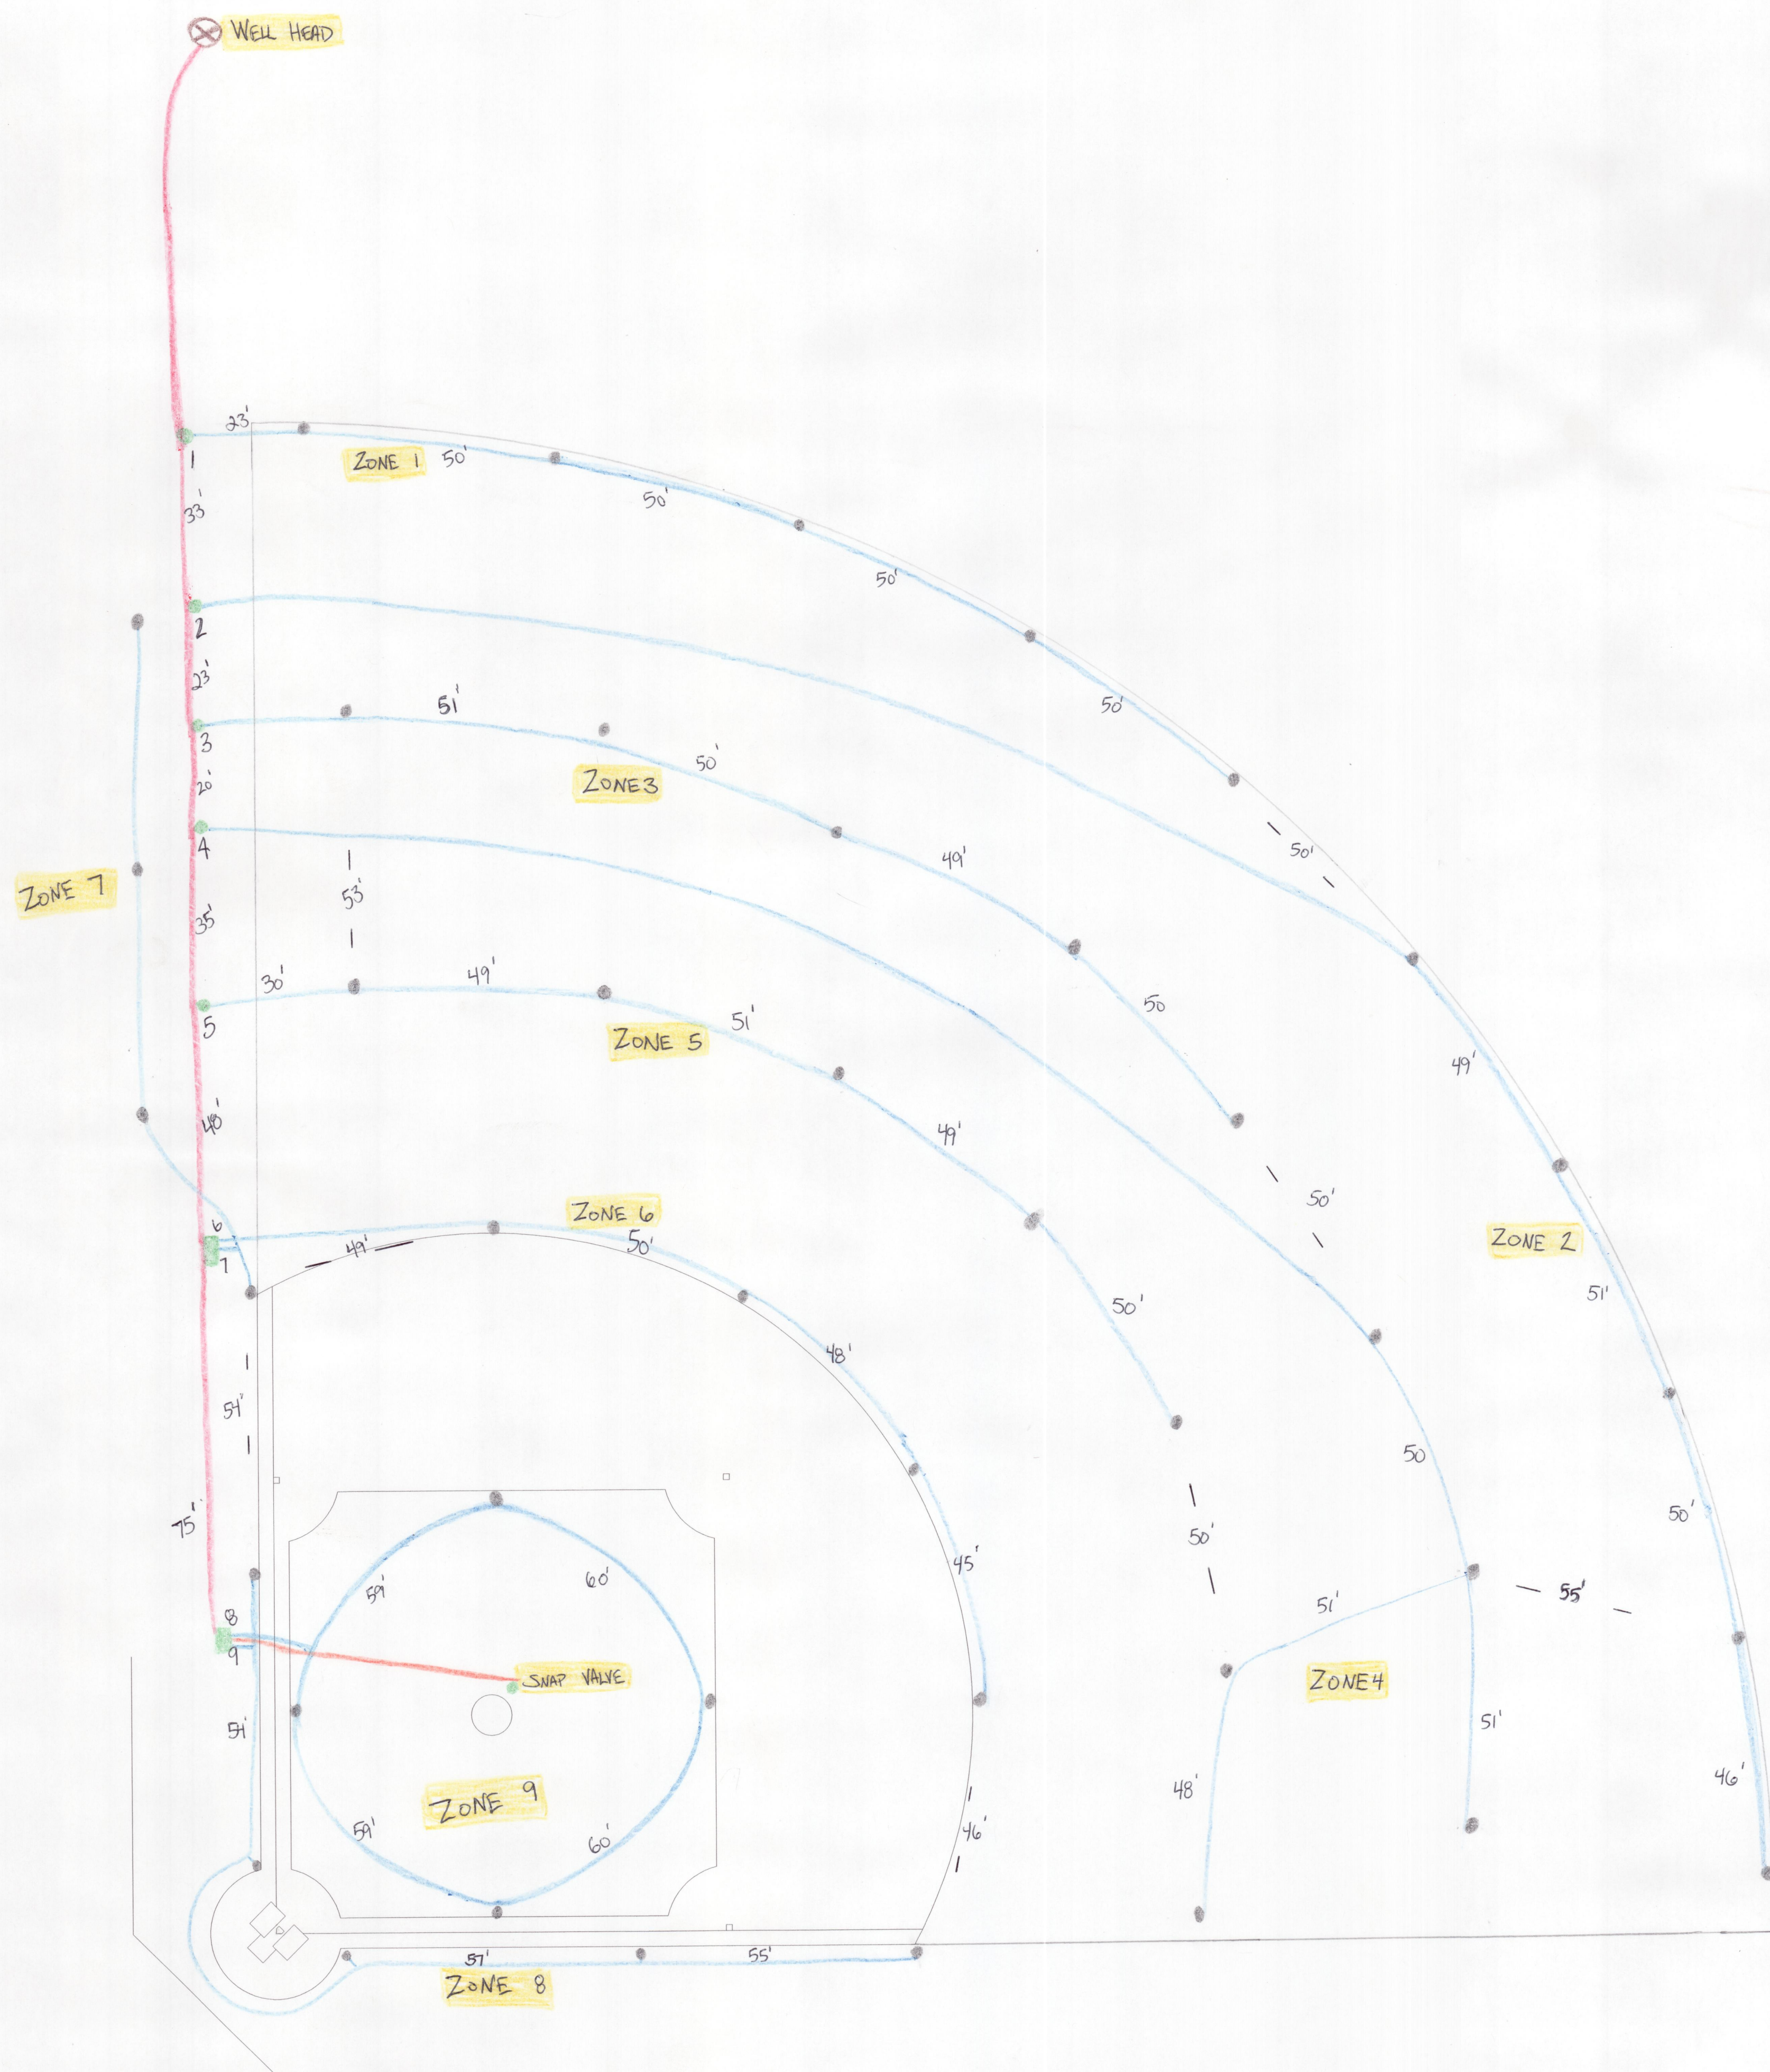

LEGEND

- HUNTER I-25 ROTARY SPRINKLER HEADS
- VALVE CONTAINMENT BOX W/ APPROPRIATE VALVE / ZONE NUMBER
- LATERAL ZONE PIPE (POST VALVE)
- MAIN PRESSURIZED PIPE & COMMUNICATION WIRE
- MAIN PRESSURIZED PIPE ONLY
- ⊗ WELL HEAD
- STATION / ZONE IDENTIFICATION

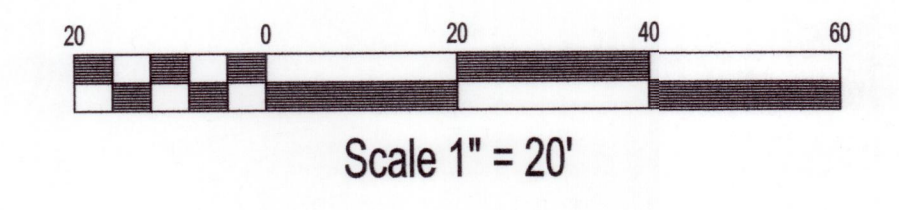

NOTE: DISTANCE BETWEEN SPRINKLERS MEASURED IN A STRAIGHT LINE - HEAD TO HEAD